

Part 2 never received 3/13

State Well Report Part 1

Mississippi Department of Environmental Quality
Office of Land and Water Resources
P.O. Box 10631
Jackson, MS 39289-0631
(601) 961-5210
(601) 354-6938 (fax)

County: Jackson
 Permit #: _____
 Driller: Coast Water Well Serv.
 Date drilling completed: 7/2/09

For Office Use Only:
 Aquifer: _____
 Well #: K632
 L. S. Elevation: _____
 E-log #: _____

State Law requires that this report be prepared by the driller in detail and filed with the Department within 30 days of completion of drilling of the well.

Well Owner Information	Well Location
Owner Name: <u>Ken Newman</u>	Latitude: <u>30° 29' 46.5"</u> Longitude: <u>88° 38' 68.4"</u>
Mailing Address: <u>10200 Sheephead</u>	Method of Lat/Long (circle one): Conventional Survey, <u>Hand-held GPS</u>
<u>Vanceleave, Ms 39565</u>	USGS quad, <u>Hand-held GPS</u> Survey-grade GPS
City: _____ State: _____ Zip Code: _____	<u>NW 1/4 NW 1/4 Sec 38 Twn T6S Rng R7W</u>
Telephone No. <u>(228) 826-5622</u>	Distance: <u>3 1/2</u> Miles Direction: <u>SE</u> of Nearest Town: <u>Vanceleave</u>

Well Data

Purpose of Well (circle one): Home Industrial Public Supply Irrigation Fish Culture Other: _____

Date well drilling started: 7/2/09 Date well drilling completed: 7/2/09

If flowing, method of flow regulation: Valve N/A Other (describe) _____

Static Water Level: 3 feet above or below (circle one) land surface Date measured: 7/2/09

Method of Measurement (circle one) steel tape electric tape air line other: _____

Hole depth: 120 FT. Well depth: 120 FT. Well grouted to a depth of 10 feet

Type of grout (circle one): Cement Bentonite Mix

Casing length: 110 feet Casing diameter: 2 inches Type of casing: PVC

Screen length: 10 feet Screen diameter: 2 inches Type of screen: PVC

Screen slot size: .006 inches Setting depth: From 110 feet to 120 feet

Type of completion (circle all applicable): Gravel packed Underreamed Telescoped Open hole Natural Development

Other (describe): _____

Top of lap pipe or reduction in casing: N/A feet. If telescoped or more than one screen, describe on back of page

Logs run (circle all applicable): No log run Electric Gamma Ray Density Sonic Neutron Other: _____

Name of organization running log(s): N/A

I certify that the well was drilled, constructed, and completed in accordance with all applicable requirements of the Mississippi Department of Environmental Quality and/or the Mississippi Department of Health regulations and state laws.

Jack Ridgell 0-472
Print Name of Water Well Contractor and License No.

Jack Ridgell
Signature of Water Well Contractor

RECEIVED
JUL 31 2009
BY: OLWR

If well telescopes please sketch below and show depths.

Ground Level _____

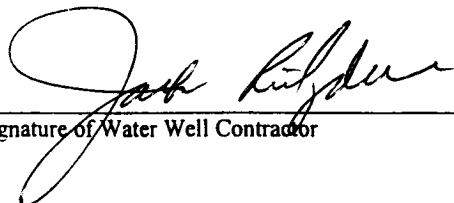
Description of Formations Encountered	From	To
TOPSOIL	0	2
Orange clay	2	25
White coarse sand	25	55
Blue clay	55	60
Gray medium sand	60	120

If more than one screen, show location of each on sketch

Sketch the property layout and include the following: 1) the well location; 2) any permanent structures on the property that may aid in locating the well; 3) any roads, power lines, or other items that may aid in locating the property and the well; 4) indicate direction.

The sketch shows a property layout with an irregular boundary. A road labeled "John's Bayou Rd" runs horizontally across the top. A driveway labeled "Sheephead Drive" leads from the road down to a small square structure labeled "House". To the right of the house is a square labeled "Well". The well is connected to the house by a line. The bottom boundary of the property is a vertical line on the right side.

Landowner Name: Ken Newman


 Signature of Water Well Contractor

RECEIVED
 JUL 31 2009
 BY: OLWR