

State Well Report

Part 1

Mississippi Department of Environmental Quality
Office of Land and Water Resources
P.O. Box 10631
Jackson, MS 39289-0631
(601) 961-5210
(601) 354-6938 (fax)

For Office Use Only:

Aquifer: K 670
Well #: _____
L. S. Elevation: _____
E-log #: _____

County: Jackson
Permit #: _____
Driller: Coast Water Well Serv.
Date drilling completed: 6/15/11

State Law requires that this report be prepared by the driller in detail and filed with the Department within 30 days of completion of drilling of the well.

Well Owner Information	Well Location
Owner Name: <u>Jeffrey Ingram</u>	Latitude: <u>30.32.192"</u> Longitude: <u>88.42.44.70"</u>
Mailing Address: <u>Jim Ramsey Rd.</u>	Method of Lat/Long (circle one): Conventional Survey, USGS quad, <u>Hand-held GPS</u> , Survey-grade GPS
<u>Vancleave, MS 39565</u>	<u>SW 1/4 SW 1/4 Sec 8 Twn T 6 S Rng R 7 W</u>
City State Zip Code	Distance Direction Nearest Town
Telephone No. <u>601 382-2584</u>	<u>1 1/2</u> Miles <u>W.S.</u> of <u>Vancleave</u>

Well Data

Purpose of Well (circle one) Home Industrial Public Supply Irrigation Fish Culture Other: _____

Date well drilling started: 6/13/11 Date well drilling completed: 6/15/11

If flowing, method of flow regulation: Valve N/A Other (describe) _____

Static Water Level: 105 feet above or below (circle one) land surface Date measured: 6/15/11

Method of Measurement (circle one) steel tape electric tape air line other: _____

Hole depth: 324 FT. Well depth: 324 FT. Well grouted to a depth of 10 feet

Type of grout (circle one): Cement Bentonite Mix

Casing length: 294 feet Casing diameter: 4 inches Type of casing: PVC

Screen length: 30 feet Screen diameter: 4 inches Type of screen: PVC

Screen slot size: 10 FT. .006 inches Setting depth: From 294 feet to 324 feet

Type of completion (circle all applicable): Gravel packed Underreamed Telescoped Open hole Natural Development

Other (describe): _____

Top of lap pipe or reduction in casing: N/A feet. If telescoped or more than one screen, describe on back of page

Logs run (circle all applicable): No log run Electric Gamma Ray Density Sonic Neutron Other: _____

Name of organization running log(s): N/A

I certify that the well was drilled, constructed, and completed in accordance with all applicable requirements of the Mississippi Department of Environmental Quality and/or the Mississippi Department of Health regulations and state laws.


Jack Riddell 0-472
Print Name of Water Well Contractor and License No.

Jack Riddell
Signature of Water Well Contractor

K670

If well telescopes please sketch below and show depths.


Ground Level

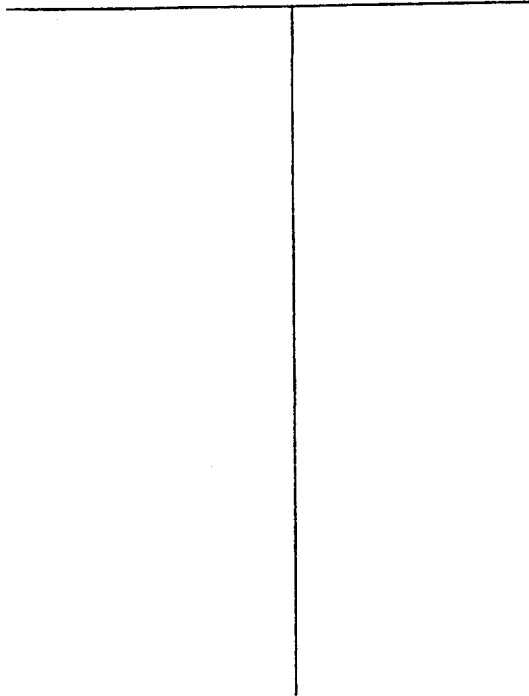


Description of Formations Encountered	From	To
Top Soil	0	2
Orange Clay	2	10
Orange coarse sand	10	20
Orange clay	20	65
Blue clay	65	88
Brown coarse sand w/pea gravel	88	129
Orange clay	129	138
Brown coarse sand w/pea gravel	138	165
Blue clay	165	181
Gray coarse sand	181	194
Blue clay	194	272
Gray medium to coarse sand	272	324

If more than one screen, show location of each on sketch

Sketch the property layout and include the following: 1) the well location; 2) any permanent structures on the property that may aid in locating the well; 3) any roads, power lines, or other items that may aid in locating the property and the well; 4) indicate direction.

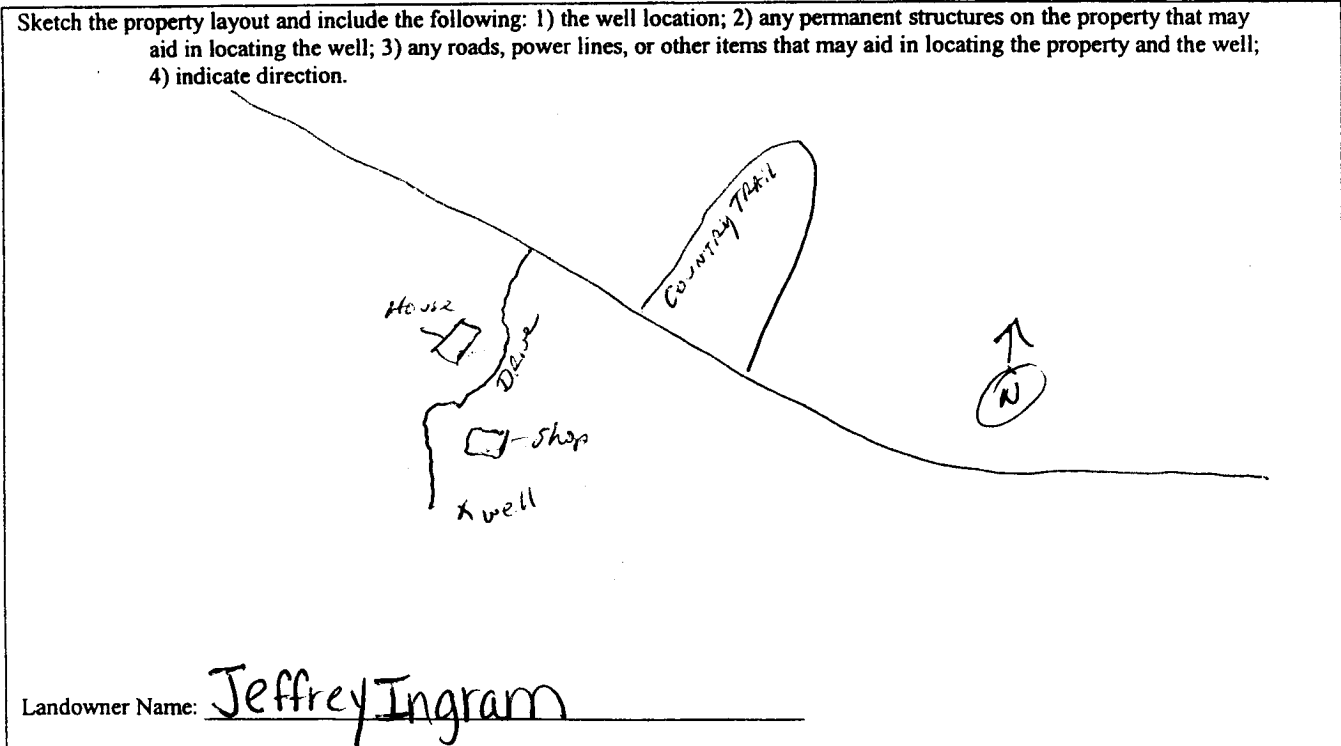

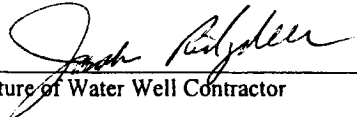
Signature of Water Well Contractor

STATE WELL REPORT

Part 2

Pump Installer's Completion Report
Mississippi Department of Environmental Quality
Office of Land and Water Resources
P.O. Box 10631
Jackson, MS 39289-0631
(601) 961-5210
(601) 354-6938 (fax)

For Office Use Only:

Aquifer: _____

Well #: _____

Elevation: _____

County: Jackson
Permit #: _____
Driller: Coast Water Wells SRV.
Date completed: 6/15/11

This report should be prepared by the pump installer in detail and filed with the Department within 30 days of the installation of pump.

Well Owner Information	Well Location
Owner Name: <u>Jeffrey Ingram</u>	Latitude: <u>30° 32' 1.92"</u> Longitude: <u>088° 42' 44.70"</u>
Mailing Address: <u>Jim Ramsey Rd.</u>	Method of Lat/Long (circle one): Conventional Survey,
<u>Vanceave, Ms 39565</u>	USGS quad: <u>Hand-held GPS</u> Survey-grade GPS
City State Zip Code	<u>SW 1/4 SW 1/4 Sec 8 Twn T6S Rng R2W</u>
Telephone No. <u>228 382-2584</u>	Distance Direction Nearest Town
	<u>1 1/2 Miles West of Vanceave</u>

Pump Type Circle one	Power Type Circle one
Air Lift Jet <u>Submersible</u>	Diesel Engine Gasoline Engine Natural Gas
Bucket Piston Turbine <u>Electric Motor</u>	Hand Tractor PTO
Centrifugal Rotary Flowing Well	Windmill Other (specify): _____
Other (specify): _____	Horse Power Rating of Motor: <u>5 H.P.</u>
Date Pump Installed: <u>6/16/11</u>	Setting Depth: <u>200 FT. Dropline</u> feet
Rated Pump Capacity: <u>55</u> Gallons Per Minute	Number of Stages: <u>15</u>

Pump Test Data	Method of Measuring Water Level Circle one
Date Well Tested: <u>6/16/11</u>	<u>Air Line</u> Electric Measuring Line Steel Tape
Static Water Level (A): <u>105</u> Feet Below Land Surface	Other (specify): _____
Pumping Water Level (B): <u>N/A</u> Feet Below Land Surface	For flowing well, measured shut in head: <u>N/A</u> feet
Drawdown [(B) - (A)]: <u>N/A</u> Feet Below Land Surface	Well yielded <u>75</u> GPM with a drawdown of
Test Pumping Rate: <u>58</u> Gallons Per Minute	<u>N/A</u> feet after <u>N/A</u> hours of pumping
Duration of Pump Test (minimum 4 hours): <u>5</u> hours	

I HEREBY CERTIFY that the above statements are true to the best of my knowledge.

Jack Kidadell 0472
Print Name of Pump Installer and License No. (if applicable)

Jack Kidadell
Signature of Pump Installer