State W	ell Report				
P	art 1 For Office Use Only:				
Mississippi Department	t of Environmental Quality Aquifer:				
	nd Water Resources lox 10631 Well #:				
Jackson, M	L. S. Elevation:				
	961-5210 4-6938 (fax) E-log #:				
State Law requires that this report be prepared by the 30 days of completion of drilling of the well.	driller in detail and filed with the Department within				
Well Owner Information	Well Location				
	Katitude: <u>30.32.3.00</u> " Longitude <u>188.39.58.86</u> "				
Mailing Address: KINNEth Cirle Rd.	Method of Lat/Long (circle one): Conventional Survey,				
	USGS quad, Hand-held GPS, Survey-grade GPS				
Vancleave, ms. 37565 City State Zip Code	SE 4 Secte Twn 65 Rng R7 W				
Telephone No. 23 229-5876	Distance Direction Nearest Town <u>1'1'9</u> Miles EAST of VANCLEARE				
Well I	Data				
Purpose of Well (circle one) (Home) Industrial Public Supply	Irrigation Fish Culture Other:				
Date well drilling started: Date w	vell drilling completed: <u> </u>				
If flowing, method of flow regulation: Valve NA Other (d	escribe)				
Static Water Level: 35feet above or below (circle one) l	and surface Date measured: <u><u></u></u>				
Method of Measurement (circle one) steel tape electric tape	air line other:				
Hole depth: 130 FT. Well depth: 130 FT	Well grouted to a depth offeet				
Type of grout (circle one): Cement Bentonite Mix					
Casing length: 120_feet Casing diameter: 2	_inches Type of casing: PVC				
Screen length: feet Screen diameter:	inches Type of screen:				
Screen slot size: <u>1000</u> inches Setting depth: From _	120 feet to 130 feet				
Type of completion (circle all applicable): Gravel packed Under	reamed Telescoped Open hole Natural Development				
Other (describe):					
Top of lap pipe or reduction in casing: $N \not\mid A$ feet. If tel	escoped or more than one screen, describe on back of page				
Logs run (circle all applicable): No log run Electric Gamma Ray Density Sonic Neutron Other:					
Name of organization running log(s):N/A					
I certify that the well was drilled, constructed, and completed in a Department of Environmental Quality and/or the Mississippi Dep					
Department of Environmental Quality and/or the Mississippi Department of Health regulations and state laws.					
Jack Kidgdell 0-4-12	fact hilfden				
Print Name of Water Well Contractor and License No.	Signature of Water Well Contractor				

٠

۰,


If well telescopes please sketch below and show depths.

Ground Level

,

	Description of Formations Encountered	From	То
	TOPSOIL	O	2
	Orahae. Clay	2	TO
	Town Charse Sand	10	30
	Drange and White Clay,	30	70
	brown cearse. Sand	70	17
	D'owite carse, see Ri		
		╉━━━━━	
			<u> </u>
			<u> </u>
			ļ
		1	
		1	<u> </u>
		1	<u> </u>
		+	<u>.</u>
		+	ł
		+	ł
		<u> </u>	
		4	
			
		ļ	ļ
			<u> </u>
1			

If more than one screen, show location of each on sketch

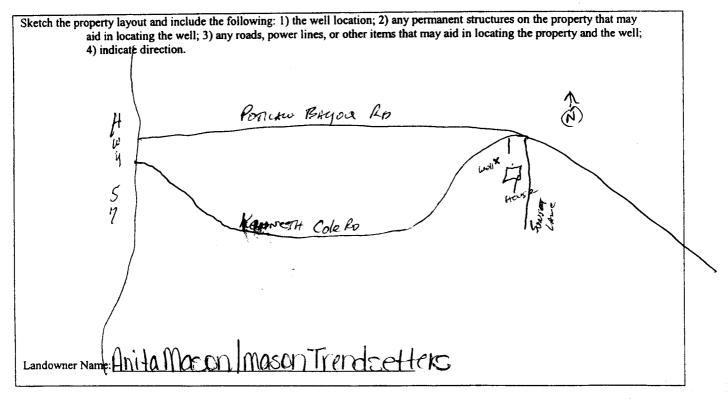

Lewis Printing - Pascagoula, MS

		ELL REPORT			
county: Jackson	Part 2 Pump Installer's Completion Report Mississippi Department of Environmental Quality Office of Land and Water Resources P.O. Box 10631 Jackson, MS 39289-0631		For Office Aquifer:	For Office Use Only: Aquifer: Well #:	
Permit #: Driller (DOST Water Wells			Well #:		
Date completed: 9/1/11		01) 961-5210) 354-6938 (fax)	Elevation:	Elevation:	
This report should be prepared by t	be pump installer in de	etail and filed with the Depart	ment within 30 days	of the	
installation of pump. Well Owner Informs	tion	•	Vell Location		
Owner Name: ANI-19 MASON	Maconkette	Latitude 233 3.C	Longitude: <u>U88</u>	59 /38.86	
Mailing Address: KANNETH CO	e Ro	C Method of Lat/Long (circle			
	Mazzir		and-held GPS, Surve	/	
Val Pave City State	Zip Code	5 <u>SE 1/2 SE 1/2 Sec</u>			
$m^2 n^2 n^2 \sigma$	5896	Distance Direction	of		
Telephone No (18) (1-5)	<u> </u>			······································	
Pump Type Circle one	<u> </u>		Power Type Circle one		
Air Lift Jet	Submersible	Diesel Engine Gas	oline Engine	Natural Gas	
Bucket Piston	Turbine	Electric Motor Har	nd	Tractor PTO	
Centrifugal Rotary	Flowing Well	Windmill Oth	er (specify):		
Other (specify):		Horse Power Rating of Mo			
Date Pump Installed:		Setting Depth: 60FT. C		eet	
Rated Pump Capacity:	_Gallons Per Minute	Number of Stages:	2		
Pump Test Data		Method of	Measuring Water La	evel	
Date Well Tested: 9 2 1	 	Air Line Electric N	Circle one	Steel Tape	
Static Water Level (A): 35 Fee	t Below Land Surface	Other (specify):	-	-	
	Below Land Surface		•	Il a	
	t Below Land Surface	For flowing well, measured		feet	
Test Pumping Rate:		Well yielded <u>22</u> <u>NA</u> feet afte	$\underline{\qquad} GPM \text{ with a draw } \mathbf{A} \mathbf{A} \mathbf{A} \mathbf{A} \mathbf{A}$		
Duration of Pump Test (minimum 4 hours): <u> </u>	feet afte	rhou	rs of pumping	
I HEREBY CERTIFY that the above state	ments are true to the bor	t of my knowledge	<u></u>		
Jack Ridadell (2-472	Ach	Raffue	1	
Print Name of Pump Installer and License	No. (if applicable)	Signature of Pump	o installer		