State W	ell Report				
route tackson P	art 1	For Office Use Only:			
Mississippi Departmen	t of Environmental Quality nd Water Resources	Aquifer:			
	lox 10631	Well #:K694			
Jackson, M	IS 39289-0631	L. S. Elevation:			
	961-5210 4-6938 (fax)	E-log #:			
State Law requires that this report be prepared by the driller in detail and filed with the Department within 30 days of completion of drilling of the well.					
Well Owner Information		Location			
Owner Name John W. Holder	Latitude: 30 . 3	2. Longitude: 088. 38 . 46.44			
Mailing Address: MT, Pleasant Rd.	06 Method of Lat/Long (circle on	e): Conventional Survey,			
	USGS quad, Hand-held	i GPS, Survey-grade GPS			
Vancleave, ME 39565 City State Zip Code	Sur 1/4 Sw 1/4 Sec 13	1 Twn T65 Rng R7W			
City State Zip Code Telephone No. (208 217-2738	Distance Direction	Nearest Town of <u>Vancleane</u>			
Weil	Data				
Purpose of Well (circle one) Home Industrial Public Supply Irrigation Fish Culture Other:					
	vell drilling completed: 3/3	26/12			
If flowing, method of flow regulation: Valve N/A Other (d		2/24/10			
Static Water Level: <u>30</u> feet above or below (circle one)	\sim	5/76/12			
Method of Measurement (circle one) steel tape electric tape air line other:					
Hole depth: 144 FT. Well depth: 144 FT.	Well grouted to a depth of	6 feet			
Type of grout (circle one): Cement Bentonite Mix					
Casing length: 134 feet Casing diameter: 2 inches Type of casing: PVC					
Screen length: 10_feet Screen diameter: 3inches Type of screen: PVC					
Screen slot size: <u>COC</u> inches Setting depth: From <u>134</u> feet to <u>144</u> feet					
Type of completion (circle all applicable): Gravel packed Underreamed Telescoped Open hole Natural Development					
Other (describe):		~			
Top of lap pipe or reduction in casing: N/A feet. If telescoped or more than one screen, describe on back of page					
Logs run (circle all applicable): No log run Electric Gamma Ray Density Sonic Neutron Other:					
Name of organization running log(s): N/A					
I certify that the well was drilled, constructed, and completed in accordance with all applicable requirements of the Mississippi					
Department of Environmental Quality and/or the Mississippi Department of Health regulations and state laws.					
Jack Ridgdell 0-472	Jack	Kiljelen			
Print Name of Water Well Contractor and License No.	Signature of	Water Well Contractor			
		 λυυ 1.2 αθ1α			

,

,

Lewis Printing - Pascagoula, NS 2012

SY: OLWR


K694

If well telescopes please sketch below and show depths.

Ground Level

Description of Formations Encountered	From	To
TOD SOI	O	2
Orange Clay	a	15
Orange Coarse Sand	15	28
Orange Clan	ରଃ	115
	113	744
prange Coarse Sana		114

If more than one screen, show location of each on sketch

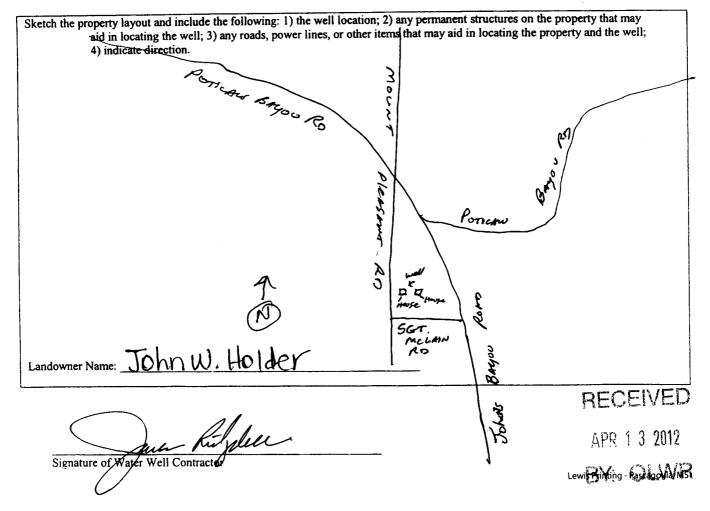

STATE WELL REPORT						
County: Jackson Permit #: Driller: DOSHUATEN WELLSRV. Date completed: 3/26/12	Part 2 Pump Installer's Completion Report Mississippi Department of Environmental Quality Office of Land and Water Resources P.O. Box 10631 Jackson, MS 39289-0631 (601) 961-5210 (601) 354-6938 (fax)		ality Aquifer: Well #: _	K 694		
This report should be prepared by the pump installer in detail and filed with the Department within 30 days of the						
installation of pump. Well Owner Information Owner Name: John W. Hold Mailing Address: MT. Pleasant Vanckave. M City State Telephone No. (283217-273	tion CY Rd. S 39565 Zip Code	Latitude: <u>30° 31' ل</u> Method of Lat/Long USGS qu <u>کال ساک</u> ۲۵	Well Location e · 30 ¹¹ Longitude (circle one): Conver ad, (Hand-held GPS, Sec / 3 Twn 7 rection Neares	$\frac{088^{\circ}38' 4(44')}{4(44')}$ ntional Survey, Survey-grade GPS $\frac{65}{65} \operatorname{Rng} \frac{R7}{2} \omega$ st Town		
Pump Type Circle one			Power Type Circle one			
Air Lift Jet	Submersible	Diesel Engine	Gasoline Engine	Natural Gas		
Bucket Piston	Turbine	Electric Motor	Hand	Tractor PTO		
Centrifugal Rotary Other (specify):	Flowing Well	Windmill Horse Power Rating Setting Depth: (20) Number of Stages: _	of Motor: 1 HP			
Pump Test Data Date Well Tested: 30712 Static Water Level (A): 30 Feet	Below Land Surface	Air Line Ele	od of Measuring Wa Circle one ctric Measuring Line	Steel Tape		
Drawdown [(B) - (A)]: <u>NA</u> Feet	Below Land Surface Below Land Surface Gallons Per Minute	. 1/.	easured shut in head:			
I HEREBY CERTIFY that the above statements are true to the best of my knowledge. JACK KIAAU D-472 Print Name of Pump Installer and License No. (if applicable) Signature of Pump Installer BY: OLWF Lewis Printing - Pascagoula, MS						

.

. • • •