State V	Vall Danart				
	Vell Report	For Office Use Only:			
	Part 1 nt of Environmental Quality	Aquifar			
	and Water Resources	Aquifer:			
POR LILLA IN DIL PIU PO	Box 10631	Well #:K700			
Driller: LLOT WITTO WELLOW Jackson, I	MS 39289-0631	L. S. Elevation:			
) 961-5210				
(601) 3	54-6938 (fax)	E-log #:			
State Law requires that this report be prepared by the driller in detail and filed with the Department within 30 days of completion of drilling of the well.					
Well Owner Information	Wel	Location			
Owner Name Jimmy Heirs HIELS	Latitude: 30.32 ,11.94	" Longitude: 188 • 39 , 59, 94"			
Mailing Address: Kenneth Cde Rd.	Child of Lat/Long (circle one): Conventional Survey,				
	USGS quad, (Hand-held	GPS Survey-grade GPS			
Varience, MS 39565	SEWSE Viser 10	TwnT65 Rng BEW			
Vancleave, MS 39565 City State Zip Code	INE	7W			
Telephone No. 238) 826-3958	I Distance Direction Nearest Town				
lelephone No. (200) Dalo- 34.58	MilesAST	of vaneleasur			
Well	Data				
Purpose of Well (circle one Home Industrial Public Supply Irrigation Fish Culture Other:					
Date well drilling started: $3/16/12$ Date well drilling completed: $3/16/12$					
If flowing, method of flow regulation: Valve <u>NA</u> Other (describe)					
Static Water Level: 40 feet above or pelow scircle one) land surface Date measured: 3/16/13					
Method of Measurement (circle one) steel tape electric tape air line other:					
Hole depth: 127FT. Well depth: 127FT. Well grouted to a depth of 10 feet					
Type of grout (circle one): Cement Bentonite Mix					
Casing length: <u>117</u> feet Casing diameter: <u>2</u> inches Type of casing: <u>PVC</u>					
Screen length: <u>10</u> feet Screen diameter: <u>2</u> inches Type of screen: <u>PVC</u>					
Screen slot size:					
Type of completion (circle all applicable): Gravel packed Underreamed Telescoped Open hole Natural Development					
Other (describe):	······				
Top of lap pipe or reduction in casing: \mathcal{N}/\mathcal{A} feet. If telescoped or more than one screen, describe on back of page					
Logs run (circle all applicable): No log run Electric Gamma Ray Density Sonic Neutron Other:					
Name of organization running log(s): N/A					
I certify that the well was drilled, constructed, and completed in accordance with all applicable requirements of the Mississippi					
Department of Environmental Quality and/or the Mississippi Department of Health regulations and state laws.					
Tel CILLI	$\langle \rangle$	RECEIVED			
Jack Kidgdell	tech .	Kulplice			
Print Name of Water Well Contractor and License No.	Signature of	Water Well Contractor PR 1 3 2012			
		DVA ALMA			

,

•


If well telescopes please sketch below and show depths.

immy fleirs

Signature of Water Well Contractor

Landowner Name: (

۰.

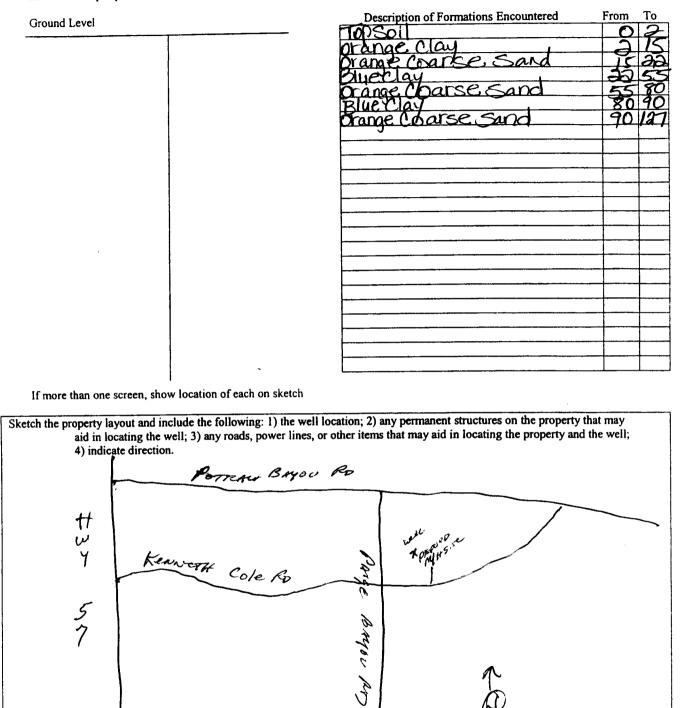

APR 1 3 2012 BY: OLWR

٠,

RECEIVED

Lewis Printing - Pascagoula, MS

STATE WELL REPORT						
County: Jackson Permit #: Driller Mastulater Wellsky. Date completed: 3/16/12	Part 2 Pump Installer's Completion Report Mississippi Department of Environmental Quality Office of Land and Water Resources P.O. Box 10631 Jackson, MS 39289-0631 (601) 961-5210 (601) 354-6938 (fax)		For Office U Aquifer: K 7 (Well #: Elevation:	<u> </u>		
This report should be prepared by th	ne pump installer in deta	il and filed with the Departmo	ent within 30 days of	f the		
installation of pump. Well Owner Informat Owner Name: Jimmy Hiers Mailing Address: KINNETH CO Vancleave Ms City State	Well Location Well Location Latitude: $30^\circ 3 \Rightarrow '11.94''$ Longitude: $088^\circ 39'50'$ Method of Lat/Long (circle one): Conventional Survey, USGS quad, Hand-held GPS, Survey-grade GPS S395L65 Zip Code N E Distance Direction Nearest Town		$\frac{39'59.94'}{1000}$ srvey, grade GPS ng $\frac{1}{710}$			
Telephone No. 208 826-395	<u> </u>	1/2 Miles EAST of Vancleaves				
Pump Type Circle oneAir LiftJetBucketPistonCentrifugalRotaryOther (specify):	Submersible Turbine Flowing Well Gallons Per Minute	Diesel Engine Gasoli Electric Motor Hand	(specify): -: -: -:			
Pump Test Data Date Well Tested: $4/1110$ Static Water Level (A): 40 Feet Below Land Surface Pumping Water Level (B): N/A Feet Below Land Surface Drawdown [(B) – (A)]: N/A Feet Below Land Surface Test Pumping Rate: $5/5$ Gallons Per Minute Duration of Pump Test (minimum 4 hours): $4/4$ hours		Method of Measuring Water Level Circle one Air Line Electric Measuring Line Steel Tape Other (specify):				
I HEREBY CERTIFY that the above staten <u>Jack Ridg dell</u> 0477 Print Name of Pump-Installer and License M	2	of my knowledge. Signature of Pump In		RECEIVED MAY 0 4 2012 htting - Pascagoula, MS BY: OLWR		

•