
Trakeno	P	art 1	For Office Use Only:	
County: CCRUI		of Environmental Quality	Aquifer:	
Permit #:		nd Water Resources	Well #: K714	
Driller: Cast Water Wells RV	P.O. Box 10631 Jackson, MS 39289-0631		L. S. Elevation:	
Date drilling completed: $4-39-13$		961-5210	L. S. Elevation:	
	(601) 354-6938 (fax)		E-log #:	
State Law requires that this report be prepared by the driller in detail and filed with the Department within 30 days of completion of drilling of the well.				
	Well Owner Information		Location	
Owner Name Jased Lock	wner Name Jased Locklear		Longitude: <u>(188° 39° 5.78</u> "	
Mailing Address: Paige Ba	Mailing Address: Paige Bayourd		e): Conventional Survey,	
			GPS Survey-grade GPS	
Vary Cave (Y) S 39565 City State Zip Code		NE 1/4 NE 1/4 Sec 27	Twn 765 Rng R7w	
Telephone No. (28) 217 - 170	· · · · · · · · · · · · · · · · · · ·	Distance Direction Miles 56	Nearest Town of VAncletue	
	Weil I	Pata		
Purpose of Well (circle on Home Ind	ustrial Public Supply	Irrigation Fish Culture	Other:	
Date well drilling started: $4-29-13$ Date well drilling completed: $4-29-13$				
If flowing, method of flow regulation: Val	Ive N/A Other (de	escribe)		
Static Water Level: 20 feet above or below circle one) land surface Date measured: 4-29-13				
Method of Measurement (circle one) steel tape electric tape air line other:				
Hole depth: 137FT Well depth: 137FT Well grouted to a depth of 10 feet				
Type of grout (circle one): Cement	Bentonite Mix			
Casing length: 127 feet Casing diameter: 2 inches Type of casing: PVC				
Screen length: 10 feet Screen diameter: 2 inches Type of screen: PVC				
Screen slot size: , OOO inches Setting depth: From 137 feet to 137				
Type of completion (circle all applicable): Gravel packed Underreamed Telescoped Open hole Natural Development				
	Other (describe):	***		
Top of lap pipe or reduction in casing:feet. If telescoped or more than one screen, describe on back of page				
Logs run (circle all applicable) No log run Electric Gamma Ray Density Sonic Neutron Other:				
Name of organization running log(s):				
I certify that the well was drilled, constructed, and completed in accordance with all applicable requirements of the Mississippi				
Department of Environmental Quality and/or the Mississippi Department of Health regulations and state laws.				
Ack Kidgdell 0 472 Jan Righting			Rifshur	
Print Name of Water Well Contractor and	License No.	Signature of V	Water Well Contractor	

State Well Report

For Office Use Only:

If well telescopes please sketch below and show	depths.	
Ground Level	Description of Formations Encountered	From To
Glodia Bevel	Top soil	$\frac{U}{2}$
	orange Clay	2/5
	Brown Coarde. Sand	15 40
	Orange Clay	45 100
	Brown Coarses sand	16013
		
Ì		
		
·		

If more than one screen, show location of each on sketch

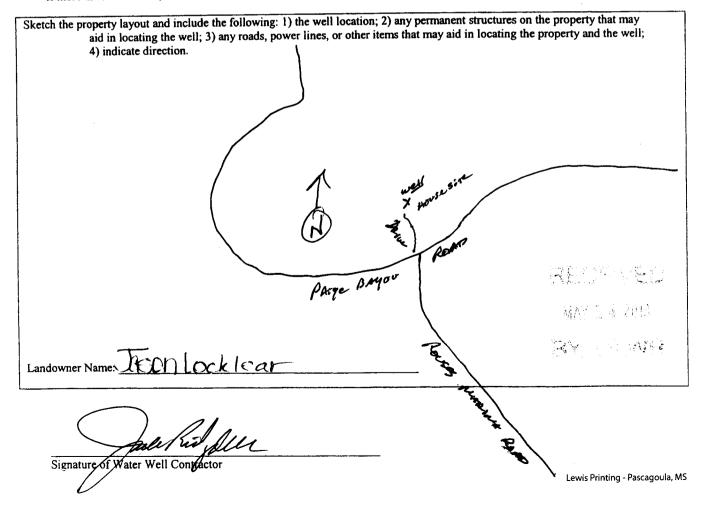

STATE WELL REPORT

County: _ Permit

Part 2

Pump Installer's Completion Report Mississippi Department of Environmental Quality Office of Land and Water Resources

For Office Use Only:		
Aquifer:		
Well #:	14714	
Elevation:		

Driller COSTWATER WEILS AV	P.O. Box 10631 Jackson, MS 39289-0631 Well #:			
Date completed: 4-29-13	(601) 961-5210			
	(601) 354-6938 (fax)			
This report should be prepared by the pump installer in detail and filed with the Department within 30 days of the installation of pump.				
Well Owner Information	Well Location			
Owner Name: Jared locklear	Latitude: 30° 30′, 030′′ Longitude: 088° 37′5, 78′′			
Mailing Address: Page Bayou Rd.	Method of Lat/Long (circle one): Conventional Survey,			
,	USGS quad Hand-held GPS, Survey-grade GPS			
Vancleare, Ms 3956 City State Zip C	5 NE 1/4 NE 1/4 Sec 27 Twn T65 Rng A7W			
City State Zip C	ode Distance Direction Nearest Town			
Telephone No. 28217-1767				
	Power Trans			
Pump Type Circle one	Power Type Circle one			
Air Lift Jet Submersible	e Diesel Engine Gasoline Engine Natural Gas			
Bucket Piston Turbine	Electric Motor Hand Tractor PTO			
Centrifugal Rotary Flowing W				
Other (specify):	Horse Power Rating of Motor:			
Date Pump Installed: 5/6//3	Setting Depth: 40FT, Droplife feet			
Rated Pump Capacity: Gallons Per	Minute Number of Stages:			
Pump Test Data	Method of Measuring Water Level			
Date Well Tested: 5/6/13	Circle one			
Static Water Level (A):Feet Below Land	Air Line Electric Measuring Line Steel Tape			
Pumping Water Level (B): Feet Below Land	Other (specify):			
. 11				
Drawdown [(B) – (A)]: N A Feet Below Land	Surface For flowing well, measured shut in head:feet			
Test Pumping Rate:OGallons Per	Minute Well yielded 24 GPM with a drawdown of			
Duration of Pump Test (minimum 4 hours):	hours			
Print Name of Pump Installer and License No. (if applicable) I HEREBY CERTIFY that the above statements are true to the best of my knowledge. Print Name of Pump Installer Signature of Pump Installer				