

STATE WELL REPORT

Part 1

Driller's Log

Mississippi Department of Environmental Quality
Office of Land and Water Resources
P.O. Box 2309
Jackson, MS 39225-2309
(601)961-5210
(601)360-0535 (fax)

County: Jackson
 Permit #: _____
 Driller: Coast Water Wells Serv.
 Date drilling completed: 9-10-13

For Office Use Only:

Well #: K718
 Aquifer: _____
 E-Log #: _____

State Law requires that this report be prepared by the license holder responsible for the work and filed with the Department at the above address within 30 days of completion of drilling of the well or borehole.

Well Owner Information <small>(Landowner if borehole is not for a water well)</small>	Well or Borehole Location
Owner Name: <u>Fred Harwell</u>	Latitude: <u>30° 30' 33.30"</u> Longitude: <u>088° 43' 41.52"</u>
Mailing Address: <u>Pine Wood Hills Rd</u>	Method of Lat/Long (check one): Conventional Survey _____, USGS quad _____, Hand-held GPS <input checked="" type="checkbox"/> , Survey-grade GPS _____
<u>Vanceleave, ms 39565</u>	<u>SW 1/4 NW 1/4, Sec 19 T 6 S R 7 W</u>
City State Zip Code	<u>2 1/2</u> Miles <u>SW</u> of <u>Vanceleave</u>
Telephone No. <u>(601) 520-2975</u>	(Distance) (Direction) (Nearest Town)

Well / Borehole Data

Date drilling started: 9-10-13 Date drilling completed: 9-10-13 Hole depth: 165' Hole diameter: 2

Location of the source of any surface water used for drilling: N/A

Method of dosing and volume of Chlorine used in drilling and development: 1 gal per 1000 drilling = 2 gal in well

Logs run (circle all applicable): No log run Electric Gamma Ray Density Sonic Neutron Other: _____

Name of organization running log(s): _____

Purpose of borehole (circle one): Water Well Geotechnical/Geological Investigation Ground Source Heat Pump
 Seismic Survey Other (describe) _____

If drilling is not related to water well construction, skip the remainder of this block

Purpose of Well (circle all applicable): Home Industrial Public Supply Irrigation Fish Culture
 Other (describe): Live stock (Cows) → Drinking water

If a flowing well, method of flow regulation: Valve _____ Other (describe) _____

Static Water Level: 40 feet [above or below] land surface Date measured: 9-10-13
(circle one)

Method of measurement (circle one): Steel tape Electric tape Air line Other (describe): _____

Well depth: 165 Well grouted to a depth of: 10 feet Type of grout (circle one): Neat Cement Bentonite Mix

Casing length: 155 feet Casing diameter: 2 inches Type of casing: PVC

Screen length: 10 feet Screen diameter: 2 inches Type of screen: PVC

Screen slot size: .006 inches Setting depth: From 155 feet to 165 feet

Type of completion (circle all applicable): Gravel packed Underreamed Open hole Natural Development

Other (describe): _____

Top of lap pipe or reduction in casing: N/A feet


If telescoped or more than one screen, describe on next page

RECEIVED
 SEP 19 2013
 BY: OLWR
 Form: OLWR-SWR-1A (4/13)

County: Jackson
Permit #: _____

For Office Use Only:
Well #: 15718

The sketch below only required for water wells
If well telescopes, show depths on sketch.

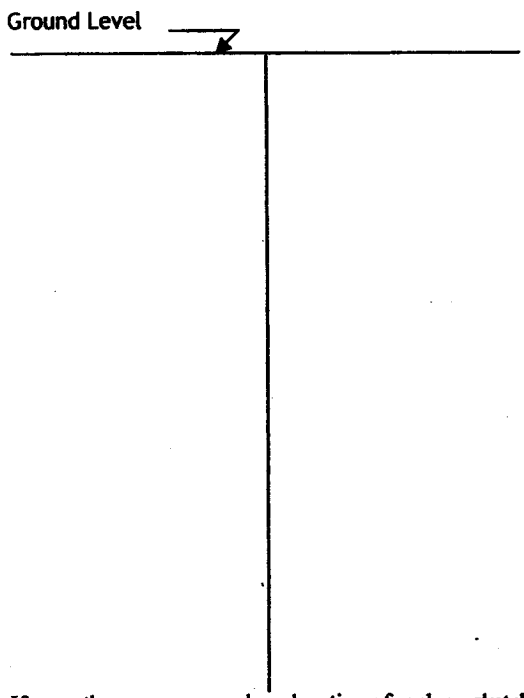


Description of formations encountered must be provided for all wells and boreholes, unless specifically exempted by regulations

Description of Formations Encountered	From (depth)	To (depth)
TOPSOIL	Ground level	2
Orange clay	2	18
Gray clay	18	75
Blue clay	75	125
Brown coarse sand	125	185

If more than one screen, show location of each on sketch

- Sketch the property layout and include the following:
- 1) the well location
 - 2) any permanent structures on the property that may aid in locating the well
 - 3) any roads, power lines, or other items that may aid in locating the property and the well
 - 4) north arrow

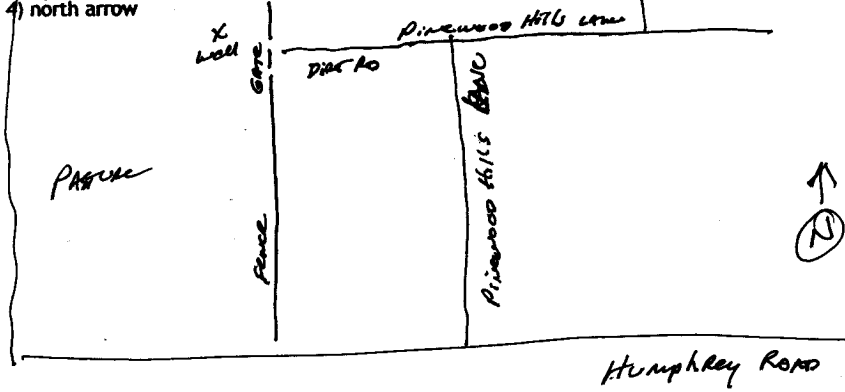

RECEIVED
SEP 19 2013
BY OLWR

Landowner Name: Fred Harwell

I HEREBY CERTIFY that the well/borehole was drilled, constructed, and completed in accordance with all applicable requirements of the Mississippi Department of Environmental Quality and the Mississippi Department of Health regulations, if applicable, and state laws.

Jack Bidadell 0-472 9/11/13 Jan Kiffner
Print Name of Responsible Licensee and License No. Date Signature of Licensee

STATE WELL REPORT

Part 2

Pump Installer's Completion Report
Mississippi Department of Environmental Quality
Office of Land and Water Resources
P.O. Box 2309
Jackson, MS 39225-2309
(601)961-5210
(601) 360-0535 (fax)

County: Jackson
Permit #: _____
Driller: Const Waterwell Serv.
Date completed: 9-10-13
Copy information from block on Part 1

For Office Use Only:
Well #: K 718
Aquifer: _____

This part of the report must be completed by a licensed water well contractor or a licensed pump installer. A copy of Part 1 of the report must be attached and both parts filed with the Department at the above address within 30 days of well completion.

Well Owner Information	Well Location
Owner Name: <u>Fred Harwell</u>	Latitude: <u>30° 30' 33.30"</u> Longitude: <u>088° 43' 41.52"</u>
Mailing Address: <u>Pinewood Hills Rd</u>	Method of Lat/Long (check one): Conventional Survey _____
<u>Vancleave, Ms 39565</u>	USGS quad _____, Hand-held GPS <input checked="" type="checkbox"/> , Survey-grade GPS <input checked="" type="checkbox"/>
City State Zip Code	<u>SW 1/4 NW 1/4, Sec 19 T 65 R 7 W</u>
Telephone No. <u>(601) 520-2975</u>	<u>2 1/2</u> Miles <u>SW</u> of <u>Vancleave</u>
	(Distance) (Direction) (Nearest Town)

Pump Type (circle one)
Submersible Turbine Air Lift Centrifugal Flowing Well Jet Piston Rotary Other (describe): _____
Date Pump Installed: 9-10-13 Rated Pump Capacity: 8 Gallons Per Minute
Is This Pump (circle one): New Repaired Replacement Used

Power Type (circle one)
 Electric Diesel Gasoline Natural Gas Tractor PTO Windmill Other (describe): _____
Horse Power Rating of Motor: 1 HP Setting Depth: 100 FT DP feet Number of Stages: 2

Pump Test Data for Non Flowing Well
Date Well Tested: 9-10-13 Duration of Pump Test (minimum 4 hours): 4 hours
Static Water Level (A): 40 Feet Below Land Surface Pumping Water Level (B): N/A Feet Below Land Surface
Drawdown [(B) - (A)]: N/A Feet Below Land Surface Test Pumping Rate: 8 Gallons Per Minute
Method of measurement (circle one): Steel tape Electric tape Air line Other (describe): _____

Pump Test Data for Flowing Well
Measured shut in head: _____ feet. N/A
Well yielded _____ GPM with a drawdown of _____ feet after _____ hours of pumping

Meter Installation
Meter Manufacturer: _____ Meter Serial Number: _____
Meter Model Number/Name: _____ Type of Meter: _____
Totalizer Register Unit and Multiplier Factor (AF x .001, gal x 1000, etc): N/A
Installation Date: _____ Meter installed by: _____
Is This Meter (circle one): New Repaired Replacement
Important: By submitting the above information you are certifying that this meter was installed to manufacturer standards. For agricultural wells, a list of approved meters is on the MDEQ website.

I HEREBY CERTIFY that the above statements are true to the best of my knowledge.
Jack Ridgell 0472 9/11/13 Jack Ridgell
Print Name of Pump Installer and License No. (if applicable) Date Signature of Pump Installer