County: <u>JACKSDM</u> Permit #: Driller_ <u>DASHWAHO_WKIJSVC</u> . Date drilling completed: <u>C_22-1.5</u> Mississippi Departr Office of La F Jackson (60)	WELL REPORT Part 1 riller's Log ment of Environmental Quality nd and Water Resources .0. Box 2309 on, MS 39225-2309 601)961-5210 1)360-0535 (fax)	For Office Use Only: Well #: <u>4</u> Aquifer: E-Log #:
State Law requires that this report be prepared by the Department at the above address within 30 days of con Well Owner Information (Landowner if borehole is not for a water well) Owner Name: Arla Waltman Mailing Address: Kenneth Cole Roap Vancleave, MS 39565	npletion of drilling of the well Well or Bore Latitude: <u>30<sup>9</sup>31<sup>9</sup>55,44</u> <sup>10</sup> Method of Lat/Long ( <i>check one</i> USGS quad, Hand-held C <u>SE</u> 4 <u>S</u> W_4, Sec_	or borehole. ehole Location ngitude: (188 40' 27,78'' e): Conventional Survey, GPS, Survey-grade GPS TG_SR_7
City State Zip Code Telephone No. 208 334-2540	$\frac{1}{(Distance)}$ Miles $\frac{E \sim E}{(Direction)}$	of <u>VArcleave</u> (Nearest Town)
	ng: <u>N/A</u> and development: <u>JgalPLr1</u>	202 Drilling Igalin wolf
If drilling is not related to water well of Purpose of Well (circle all applicable): Home Industrial Other (describe):		
If a flowing well, method of flow regulation: Valve Static Water Level:feet [above or below (circle one): Steel tape Electric	Air line Other ( <i>describe</i> feet Type of grout ( <i>circle one</i> inches Type of	e): e): Neat Cement Bentonite Mix f casing: PVC of screen: PVC tofeet
Top of lap pipe or reduction in casing: <u>N/A</u> feet If telescoped or more than	a one screen, describe on next p	Dage 300 0 ± 2015 Form: OLWR-SWR-1A (4/13) BY• OLWF-

.

.


County:	JACKSON
Permit #:	·

Fo	r Of	fice L	Jse Oi	nly:
Well #: _	K	142	5	
	,			

The sketch below only required for water wells


Description of formations encountered must be provided for all wells and boreholes, unless specifically exempted by regulations

## If well telescopes, show depths on sketch.

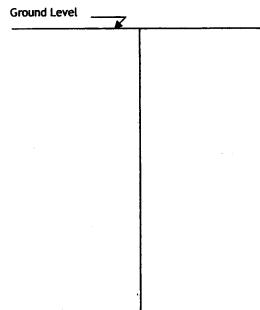

Description of Formations Encountered	From (depth)	To (depth)
TOPSOIL	Ground level	2
Orange Clay	る	15
Brown Coorse Sand	- 15	35
Orange AND Blue Clay	35	- 85
Brown Coarse Sand	85	1aO
1		

If more than one screen, show location of each on sketch

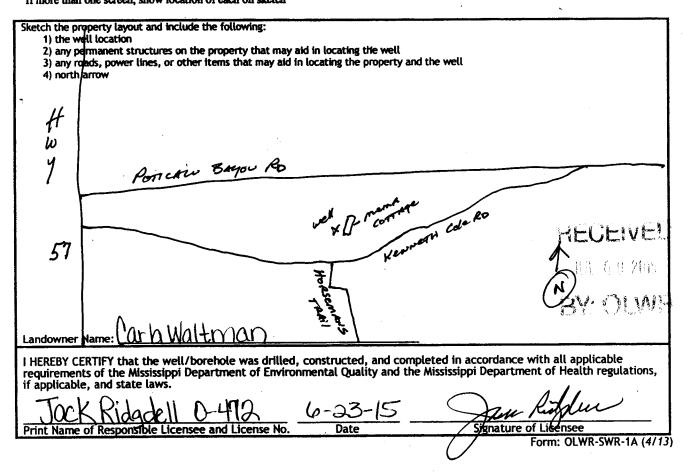

* STATE WELL	REPORT			
County: Jackaon Part				
Permit #: Pump Installer's Co	ompletion Report V 742			
Driller OST WATER WEILSVC Office of Land and	Water Resources			
Date completed: 6-22-15 P.O. Box Jackson, MS 3				
Copy information from block on Part 1 (601)961	-5210			
(601) 360-0535 (fax)				
This part of the report must be completed by a licensed water well contractor or a licensed pump installer. A copy of Part 1 of the report must be attached and both parts filed with the Department at the above address within 30 days of well completion.				
Well Owner Information	- Well Location			
Owner Name: Carla Waltman Latitu	de 30 31 55.44" Longitude: 088 40 '27.78"			
Mailing Address: KennethCole ROAD Metho	d of Lat/Long (check one): Conventional Survey,			
USGS	quad, Hand-held GPS, Survey-grade GPS			
Vancleave me 39565 State Zip Code	E 14 SW 14, sec 10 T 65 R 7W			
City State Zip Code	Miles ENE of Vancleave			
Telephone No. (288) 334-2540 (Dista	ance) (Direction) (Nearest Town)			
Pump Type (cir	cle one)			
Submersible Turbine Air Lift Centrifugal Flowing Well (jet)				
Date Pump Installed: <u>7-29-15</u> Rated P	ump Capacity: Gallons Per Minute			
Is This Pump (circle one): (New) Repaired Replacement				
Power Type (cir	cle one)			
Electric Diesel Gasoline Natural Gas Tractor PTO Windmill				
Horse Power Rating of Motor: Setting Depth: @D	FTfeet Number of Stages:			
Pump Test Data for Non Flowing Well				
Date Well Tested: 7-29-15 Dura	tion of Pump Test ( <i>minimum 4 hours</i> ): hours			
Date Well Tested: 7-29-15 Dura				
Date Well Tested: 7-29-15 Dura   Static Water Level (A): 50 Feet Below Land Surface Put	tion of Pump Test ( <i>minimum 4 hours</i> ): hours			
Date Well Tested: $7 - 29 - 15$ Dura Static Water Level (A): <u>50</u> Feet Below Land Surface Pu Drawdown [(B) - (A)]: <u>NA</u> Feet Below Land Surface	tion of Pump Test ( <i>minimum 4 hours</i> ): $$			
Date Well Tested: 7-29-15 Dura   Static Water Level (A): 50 Feet Below Land Surface Pu	tion of Pump Test ( <i>minimum 4 hours</i> ): hours mping Water Level (B):A Feet Below Land Surface Test Pumping Rate:& Gallons Per Minute in Line_Other ( <i>describe</i> ):			
Date Well Tested:   7-29-15   Dura     Static Water Level (A):   50   Feet Below Land Surface   Pu     Drawdown [(B) - (A)]:   NA   Feet Below Land Surface   Pu     Method of measurement (circle one):   Steel tape   Electric tape   Pump Test Data for	tion of Pump Test ( <i>minimum 4 hours</i> ): hours mping Water Level (B):A Feet Below Land Surface Test Pumping Rate:& Gallons Per Minute in Line_Other ( <i>describe</i> ):			
Date Well Tested:   7-29-15   Dura     Static Water Level (A):   50   Feet Below Land Surface   Pu     Drawdown [(B) - (A)]:   NA   Feet Below Land Surface   Pu     Method of measurement (circle one):   Steel tape   Electric tape   A     Pump Test Data for   1	tion of Pump Test ( <i>minimum 4 hours</i> ): hours mping Water Level (B):A Feet Below Land Surface Test Pumping Rate:& Gallons Per Minute in Line_Other ( <i>describe</i> ):			
Date Well Tested: $7-29-15$ Dura Static Water Level (A): $50$ Feet Below Land Surface Pu Drawdown [(B) - (A)]: $NA$ Feet Below Land Surface Method of measurement ( <i>circle one</i> ): Steel tape Electric tape A Pump Test Data for Measured shut in head:feet. $N/A$	tion of Pump Test ( <i>minimum 4 hours</i> ): hours mping Water Level (B): Feet Below Land Surface Test Pumping Rate: Gallons Per Minute in Line_Other ( <i>describe</i> ): Flowing Well feet after hours of pumping			
Date Well Tested: $7 - 29 - 15$ Dura     Static Water Level (A): $50$ Feet Below Land Surface   Pu     Drawdown [(B) - (A)]: $N \mid A$ Feet Below Land Surface   Pu     Method of measurement (circle one):   Steel tape   Electric tape   A     Pump Test Data for   Measured shut in head:  feet. $N \mid A$ Well yielded  GPM with a drawdown of      Meter Install   Meter Install	tion of Pump Test ( <i>minimum 4 hours</i> ): hours mping Water Level (B): Feet Below Land Surface Test Pumping Rate: Gallons Per Minute in Line_Other ( <i>describe</i> ): Flowing Well feet after hours of pumping			
Date Well Tested: $7 - 29 - 15$ Dura     Static Water Level (A): $50$ Feet Below Land Surface   Pu     Drawdown [(B) - (A)]: $N \mid A$ Feet Below Land Surface   Pu     Method of measurement (circle one):   Steel tape   Electric tape   A     Pump Test Data for   Measured shut in head:  feet. $N \mid A$ Well yielded  GPM with a drawdown of      Meter Install   Meter Install	tion of Pump Test ( <i>minimum 4 hours</i> ): hours mping Water Level (B):A Feet Below Land Surface Test Pumping Rate:B Gallons Per Minute Gallons Per Minute flowing Well feet afterhours of pumping lation			
Date Well Tested:   7-29-15   Dura     Static Water Level (A):   50   Feet Below Land Surface   Pu     Drawdown [(B) - (A)]:   N/A   Feet Below Land Surface   Pu     Method of measurement (circle one):   Steel tape   Electric tape   A     Pump Test Data for   N/A   Well yielded   Meter Install     Meter Manufacturer:   N/A     Meter Model Number/Name:   N/A	tion of Pump Test ( <i>minimum 4 hours</i> ): hours mping Water Level (B):A Feet Below Land Surface Test Pumping Rate:& Gallons Per Minute ir Line_Other ( <i>describe</i> ): Flowing Well 			
Date Well Tested:   7-29-15   Dura     Static Water Level (A):   50   Feet Below Land Surface   Pu     Drawdown [(B) - (A)]:   NA   Feet Below Land Surface   Pu     Method of measurement (circle one):   Steel tape   Electric tape   A     Pump Test Data for   NA   Pump Test Data for     Measured shut in head:  feet.   N/A     Well yielded  GPM with a drawdown of      Meter Manufacturer:  NA  NA     Meter Model Number/Name:   N/A	tion of Pump Test ( <i>minimum 4 hours</i> ): hours mping Water Level (B):A Feet Below Land Surface Test Pumping Rate:B Gallons Per Minute in line_Other ( <i>describe</i> ): Flowing Well 			
Date Well Tested:   7-29-15   Dura     Static Water Level (A):   50   Feet Below Land Surface   Pu     Drawdown [(B) - (A)]:   NA   Feet Below Land Surface   Pu     Method of measurement (circle one):   Steel tape   Electric tape   A     Pump Test Data for   NA   Pump Test Data for     Measured shut in head:  feet.   N/A     Well yielded  GPM with a drawdown of	tion of Pump Test ( <i>minimum 4 hours</i> ): hours mping Water Level (B):A Feet Below Land Surface Test Pumping Rate:B Gallons Per Minute in line_Other ( <i>describe</i> ): Flowing Well 			
Date Well Tested: $7-2(9-1S)$ Dura     Static Water Level (A): $50^{-}$ Feet Below Land Surface   Pu     Drawdown [(B) - (A)]: $N A$ Feet Below Land Surface   Pu     Method of measurement (circle one):   Steel tape   Electric tape   A     Pump Test Data for   Neasured shut in head:  feet. $N A$ Well yielded  feet. $N A$ Meter Manufacturer:  NA     Meter Model Number/Name: $N A$ Totalizer Register Unit and Multiplier Factor (AF x .001, gal x 100     Installation Date:	tion of Pump Test ( <i>minimum 4 hours</i> ): hours mping Water Level (B): Feet Below Land Surface Test Pumping Rate: Gallons Per Minute ir Line_Other ( <i>describe</i> ): Flowing Well  feet after hours of pumping lation Meter Serial Number: Type of Meter: 0, etc):			
Date Well Tested:   7-29-15   Dura     Static Water Level (A):   50   Feet Below Land Surface   Pu     Drawdown [(B) - (A)]:   NA   Feet Below Land Surface   Pu     Method of measurement (circle one):   Steel tape   Electric tape   A     Pump Test Data for   NA   Pump Test Data for     Measured shut in head:  feet.   N/A     Well yielded  GPM with a drawdown of	tion of Pump Test ( <i>minimum 4 hours</i> ): hours mping Water Level (B): Feet Below Land Surface Test Pumping Rate: Gallons Per Minute in Line_Other ( <i>describe</i> ): Flowing Well  feet afterhours of pumping lation Meter Serial Number: Type of Meter: 0, etc): me that this meter was installed to manufacturer standards.			
Date Well Tested:   7-29-15   Dura     Static Water Level (A):   50   Feet Below Land Surface   Pu     Drawdown [(B) - (A)]:   NA   Feet Below Land Surface   Pu     Method of measurement (circle one):   Steel tape   Electric tape   A     Pump Test Data for   Pump Test Data for   Pump Test Data for     Measured shut in head:  feet.   N/A     Well yielded  feet.   N/A     Meter Manufacturer:  NA     Meter Model Number/Name:	tion of Pump Test ( <i>minimum 4 hours</i> ): hours mping Water Level (B): Feet Below Land Surface Test Pumping Rate: Gallons Per Minute in Line_Other (describe): Flowing Well  feet after hours of pumping lation Meter Serial Number: Type of Meter: 0, etc): mg that this meter was installed to manufacturer standards. I meters is on the MDEQ website.			
Date Well Tested: $7-2(9-1S)$ Dura     Static Water Level (A): $50$ Feet Below Land Surface   Pu     Drawdown [(B) - (A)]: $N A$ Feet Below Land Surface   Pu     Method of measurement (circle one):   Steel tape   Electric tape   A     Pump Test Data for   Neasured shut in head:  feet. $N A$ Well yielded  feet. $N A$ Meter Manufacturer:    NA     Meter Model Number/Name:    NA     Totalizer Register Unit and Multiplier Factor (AF x .001, gal x 100   Installation Date:	tion of Pump Test ( <i>minimum 4 hours</i> ): hours mping Water Level (B): Feet Below Land Surface Test Pumping Rate: Gallons Per Minute in Line_Other (describe): Flowing Well  feet after hours of pumping lation Meter Serial Number: Type of Meter: 0, etc): mg that this meter was installed to manufacturer standards. I meters is on the MDEQ website.			
Date Well Tested:   7-29-15   Dura     Static Water Level (A):   50   Feet Below Land Surface   Pu     Drawdown [(B) - (A)]:   NA   Feet Below Land Surface   Pu     Method of measurement (clrcle one): Steel tape   Electric tape   A     Wethod of measurement (clrcle one): Steel tape   Electric tape   A     Pump Test Data for   Pump Test Data for     Measured shut in head:  feet.   N/A     Well yielded  GPM with a drawdown of	tion of Pump Test ( <i>minimum 4 hours</i> ): hours mping Water Level (B): Feet Below Land Surface Test Pumping Rate: Gallons Per Minute in Line_Other (describe): Flowing Well  feet after hours of pumping lation Meter Serial Number: Type of Meter: 0, etc): mg that this meter was installed to manufacturer standards. I meters is on the MDEQ website.			
Date Well Tested:   7-299-15   Dura     Static Water Level (A):   50   Feet Below Land Surface   Pu     Drawdown [(B) - (A)]:   NA   Feet Below Land Surface   Pu     Method of measurement (circle one):   Steel tape   Electric tape   A     Pump Test Data for   Pump Test Data for   Pump Test Data for     Measured shut in head:  feet.   N/A     Well yielded   GPM with a drawdown of      Meter Manufacturer:	tion of Pump Test (minimum 4 hours):hours mping Water Level (B):			
Date Well Tested:   7-29-15   Dura     Static Water Level (A):   50   Feet Below Land Surface   Pu     Drawdown [(B) - (A)]:   NA   Feet Below Land Surface   Pu     Method of measurement (clrcle one): Steel tape   Electric tape   A     Wethod of measurement (clrcle one): Steel tape   Electric tape   A     Pump Test Data for   Pump Test Data for     Measured shut in head:  feet.   N/A     Well yielded  GPM with a drawdown of	tion of Pump Test (minimum 4 hours):hours mping Water Level (B):			