

# STATE WELL REPORT

## Part I

### Driller's Log

Mississippi Department of Environmental Quality  
Office of Land and Water Resources  
P.O. Box 2309  
Jackson, MS 39225-2309  
(601)961-5210  
(601)360-0535 (fax)

### For Office Use Only:

Well #: K 7510  
Aquifer: \_\_\_\_\_  
E-Log #: \_\_\_\_\_

County: Jackson  
Permit #: \_\_\_\_\_  
Driller: Coast Waterwell Svc  
Date drilling completed: 9-30-15

State Law requires that this report be prepared by the license holder responsible for the work and filed with the Department at the above address within 30 days of completion of drilling of the well or borehole.

<b>Well Owner Information</b> (Landowner if borehole is not for a water well) Owner Name: <u>Scott Ely</u> Mailing Address: <u>1635 Holder Road</u> <u>Vance, MS 39565</u> City State Zip Code Telephone No. <u>(601) 656-7015</u>	<b>Well or Borehole Location</b> <u>88 38 14</u> Latitude: <u>30° 32' 31.86"</u> Longitude: <u>088° 33' 18.36"</u> Method of Lat/Long (check one): Conventional Survey _____ USGS quad _____, Hand-held GPS <input checked="" type="checkbox"/> , Survey-grade GPS _____ <u>NW 1/4 NE 1/4, Sec 12 T 65 R 7W</u> <u>3</u> Miles <u>ENE</u> of <u>Vance</u> (Distance) (Direction) (Nearest Town)
------------------------------------------------------------------------------------------------------------------------------------------------------------------------------------------------------------------------------------------------------	-------------------------------------------------------------------------------------------------------------------------------------------------------------------------------------------------------------------------------------------------------------------------------------------------------------------------------------------------------------------------------------------------------------------

<b>Well / Borehole Data</b> Date drilling started: <u>9-30-15</u> Date drilling completed: <u>9-30-15</u> Hole depth: <u>118 FT</u> Hole diameter: <u>2"</u> Location of the source of any surface water used for drilling: <u>N/A</u> Method of dosing and volume of Chlorine used in drilling and development: <u>1 gal per 1000 Drilling 2 gal in well</u> Logs run (circle all applicable): <input checked="" type="checkbox"/> No log run <input type="checkbox"/> Electric <input type="checkbox"/> Gamma Ray <input type="checkbox"/> Density <input type="checkbox"/> Sonic <input type="checkbox"/> Neutron Other: _____ Name of organization running log(s): _____ Purpose of borehole (circle one): <input checked="" type="checkbox"/> Water Well <input type="checkbox"/> Geotechnical/Geological Investigation <input type="checkbox"/> Ground Source Heat Pump <input type="checkbox"/> Seismic Survey Other (describe) _____ <i>If drilling is not related to water well construction, skip the remainder of this block</i>	
Purpose of Well (circle all applicable): <input checked="" type="checkbox"/> Home <input type="checkbox"/> Industrial <input type="checkbox"/> Public Supply <input type="checkbox"/> Irrigation <input type="checkbox"/> Fish Culture Other (describe): _____ If a flowing well, method of flow regulation: Valve _____ Other (describe) _____ Static Water Level: <u>40</u> feet [above or <input checked="" type="checkbox"/> below] and surface Date measured: <u>9-30-15</u> (circle one) Method of measurement (circle one): Steel tape <input type="checkbox"/> Electric tape <input type="checkbox"/> <input checked="" type="checkbox"/> Air line Other (describe): _____ Well depth: <u>118 FT</u> Well grouted to a depth of: <u>10</u> feet Type of grout (circle one): Neat Cement <input type="checkbox"/> Bentonite <input checked="" type="checkbox"/> Mix Casing length: <u>110</u> feet Casing diameter: <u>2</u> inches Type of casing: <u>PVC</u> Screen length: <u>8</u> feet Screen diameter: <u>2</u> inches Type of screen: <u>PVC</u> Screen slot size: <u>.006</u> inches Setting depth: From <u>110</u> feet to <u>118</u> feet Type of completion (circle all applicable): Gravel packed <input type="checkbox"/> Underreamed <input type="checkbox"/> Open hole <input checked="" type="checkbox"/> Natural Development Other (describe): _____ Top of lap pipe or reduction in casing: <u>N/A</u> feet	

If telescoped or more than one screen, describe on next page

RECEIVED

NOV 02 2015

Form: OLWR-SWR-1A (4/13)


BY: OLWR

County: Jackson  
 Permit #: \_\_\_\_\_

**For Office Use Only:**  
 Well #: K756

The sketch below only required for water wells


If well telescopes, show depths on sketch.

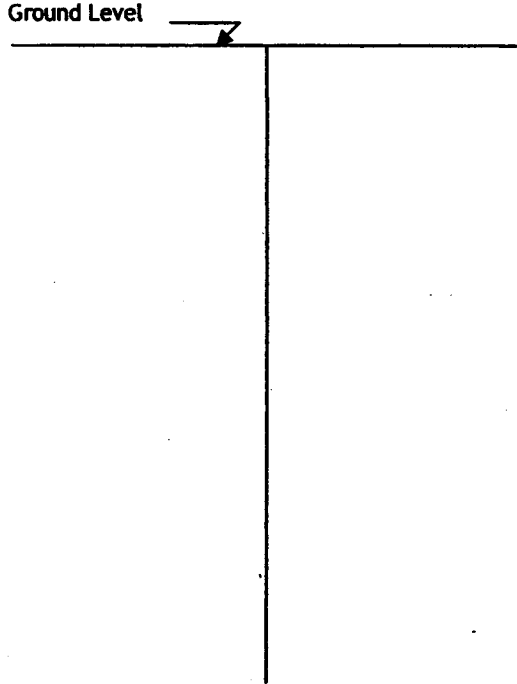

Description of formations encountered must be provided for all wells and boreholes, unless specifically exempted by regulations

Description of Formations Encountered	From (depth)	To (depth)
Top Soil	Ground level	2
Orange Clay	2	20
Orange Coarse Sand	20	32
Orange Clay	32	60
Blue Clay	60	108
Brown Coarse Sand	108	118

If more than one screen, show location of each on sketch

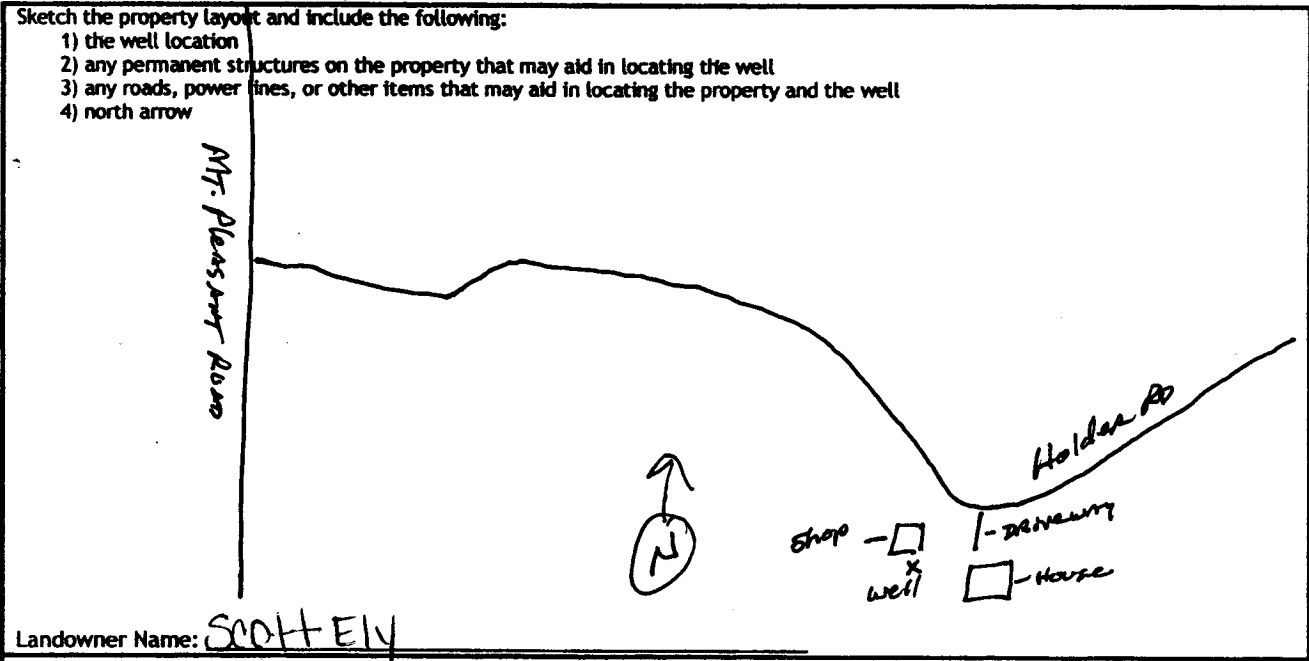

I HEREBY CERTIFY that the well/borehole was drilled, constructed, and completed in accordance with all applicable requirements of the Mississippi Department of Environmental Quality and the Mississippi Department of Health regulations, if applicable, and state laws.

Jack Ridgell 0-472 10/06/15  
 Print Name of Responsible Licensee and License No. Date

Signature of Licensee

**RECEIVED**  
 NOV 02 2015  
 Form: OLWR-SWR-1A (4/13)

**BY: OLWR**

# STATE WELL REPORT

## Part 2

**Pump Installer's Completion Report**  
 Mississippi Department of Environmental Quality  
 Office of Land and Water Resources  
 P.O. Box 2309  
 Jackson, MS 39225-2309  
 (601)961-5210  
 (601) 360-0535 (fax)

County: JACKSON  
 Permit #: \_\_\_\_\_  
 Driller: Coast Water Wells Inc  
 Date completed: 9-30-15  
*Copy information from block on Part 1*

**For Office Use Only:**

Well #: K756  
 Aquifer: \_\_\_\_\_

*This part of the report must be completed by a licensed water well contractor or a licensed pump installer. A copy of Part 1 of the report must be attached and both parts filed with the Department at the above address within 30 days of well completion.*

Well Owner Information	Well Location
Owner Name: <u>SCOTT ELY</u>	Latitude: <u>30° 32' 31.86"</u> Longitude: <u>088° 33' 18.36"</u>
Mailing Address: <u>1635 Holder Road</u>	Method of Lat/Long (check one): Conventional Survey _____, Hand-held GPS <input checked="" type="checkbox"/> , Survey-grade GPS _____
<u>Vance, MS 39565</u>	USGS quad _____, NW $\frac{1}{4}$ NE $\frac{1}{4}$ , Sec <u>12</u> T <u>6S</u> R <u>7W</u>
City _____ State _____ Zip Code _____	<u>3</u> Miles <u>ESE</u> of <u>Vance, MS</u>
Telephone No. <u>662 456-7015</u>	(Distance) (Direction) (Nearest Town)

**Pump Type (circle one)**

Submersible Turbine Air Lift Centrifugal Flowing Well  Jet  Piston Rotary Other (describe): \_\_\_\_\_

Date Pump Installed: 10-1-15 Rated Pump Capacity: 9.5 Gallons Per Minute

Is This Pump (circle one): New Repaired Replacement Existing

**Power Type (circle one)**

Electric  Diesel Gasoline Natural Gas Tractor PTO Windmill Other (describe): \_\_\_\_\_

Horse Power Rating of Motor: 1 HP Setting Depth: 60 FT. DP feet Number of Stages: 2

**Pump Test Data for Non Flowing Well**

Date Well Tested: 10-1-15 Duration of Pump Test (minimum 4 hours): 4 hours

Static Water Level (A): 40 Feet Below Land Surface Pumping Water Level (B): N/A Feet Below Land Surface

Drawdown [(B) - (A)]: N/A Feet Below Land Surface Test Pumping Rate: 8.5 Gallons Per Minute

Method of measurement (circle one): Steel tape Electric tape Air line  Other (describe): \_\_\_\_\_

**Pump Test Data for Flowing Well**

Measured shut in head: \_\_\_\_\_ feet. N/A

Well yielded \_\_\_\_\_ GPM with a drawdown of \_\_\_\_\_ feet after \_\_\_\_\_ hours of pumping

**Meter Installation**

Meter Manufacturer: \_\_\_\_\_ Meter Serial Number: \_\_\_\_\_

Meter Model Number/Name: N/A Type of Meter: \_\_\_\_\_

Totalizer Register Unit and Multiplier Factor (AF x .001, gal x 1000, etc): \_\_\_\_\_

Installation Date: \_\_\_\_\_ Meter installed by: \_\_\_\_\_

Is This Meter (circle one): New Repaired Replacement

*Important: By submitting the above information you are certifying that this meter was installed to manufacturer standards. For agricultural wells, a list of approved meters is on the MDEQ website.*

I HEREBY CERTIFY that the above statements are true to the best of my knowledge.

Jack Ridgell 0-472 10/6/15 [Signature]

Print Name of Pump Installer and License No. (if applicable) Date Signature of Pump Installer

RECEIVED  
 NOV 03 2015  
 Form: OLWR-SWR-1B (4/13)  
 BY: OLWR