

JACKSON

K 2008

2-6-75

MISSISSIPPI  
 BOARD OF WATER COMMISSIONERS  
 416 North State Street  
 Jackson, Mississippi 39201

WATER WELL DRILLERS LOG

COAST WATER WELL SERVICE INC.

2/6 1975 date well completed

firm name

Jackson county well located

LANDOWNER: Bill Mc Smith

description of formations encountered

from

to

Rt. 4 Box 257

Ocean Springs Miss.  
(mailing address)

top soil

0 4

Red clay

4 25

Blue Clay

25 52

Sand - (C)

52 140

WELL LOCATION:


sec. 10 T-6 R-7  
1 1/2 miles (distance) E of Vancleave (nearest town)

WELL PURPOSE: Home  
(home, irrigation, municipal, industrial)

WELL COMPLETION DATA:

- (1) diameter (inches) 2"
- (2) total depth (feet) 140'
- (3) static water level (feet) 36 below top of ground.
- (4) casing PVC, 130' (material), (depth)  
2" (size) If telescope see back.
- (5) screen 10' (length), 130' (depth to top)  
2" (size), PVC (material)
- (6) pump (HP) (yield gpm)  
(type power)
- (7) electric log NO (yes or no)  
(organization running log)
- (8) how well bottom plugged BWU


DRILLERS REMARKS:

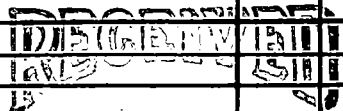

APR - 8 1975

If well telescopes please sketch and show depths.

GROUND LEVEL

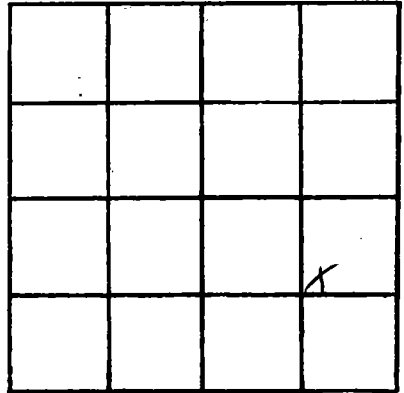

SECTION 10

Please indicate well location X.

ADDITIONAL INFORMATION

A series of horizontal lines for writing additional information.

If more than one screen, show locations of each on sketch.