

JACKSON

K 2001

2-10-76

130

75

MISSISSIPPI BOARD OF WATER COMMISSIONERS 416 North State Street Jackson, Mississippi 39201

WATER WELL DRILLERS LOG

COAST WATER WELL SERVICE INC.

Jackson

2/10 1976 date well completed

firm name

county well located

LANDOWNER: Bennie Barton

Rt. 4 Box 258 A

Ocean Springs Ms. (mailing address)

WELL LOCATION:

sec. 10 T-6 R-7 1 1/2 miles (distance) S of Vicksburg (direction) (nearest town)

WELL PURPOSE: Home (home, irrigation, municipal, industrial)

WELL COMPLETION DATA:

- (1) diameter (inches) 2"
(2) total depth (feet) 130'
(3) static water level (feet) 40 below top of ground.
(4) casing PVC 120' (material) (depth) 2" (size) if telescope see back.
(5) screen 10' 120' (length) (depth to top) 2" PVC (size) (material)
(6) pump 1 7 1/2 (HP) (yield gpm) elec. (type power)
(7) electric log NO (yes or no)
(organization running log)
(8) how well bottom plugged B W U


Table with 3 columns: description of formations encountered, from, to. Rows include: top soil (0-4), Red clay (4-25), blue clay (25-52), sand (C) (52-130).

DRILLERS REMARKS:

DISPERSED... APR 8 1976

If well telescopes please sketch and show depths.

GROUND LEVEL

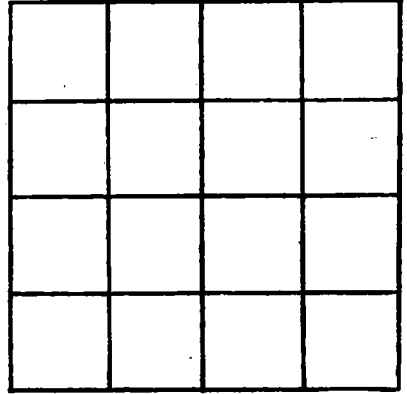

SECTION _____

Please indicate well location X.

ADDITIONAL INFORMATION

If more than one screen, show locations of each on sketch.