

JACKSON
K 2002
3-30-75

MISSISSIPPI
BOARD OF WATER COMMISSIONERS
416 North State Street
Jackson, Mississippi 39201

WATER WELL DRILLERS LOG

COAST WATER WELL SERVICE INC.

Jackson

3/30 1975
date well completed

firm name

county well located

LANDOWNER: Wendell Starn

description of formations encountered

from to

P.O. Box 1676

top soil

0 5

Gulfport, Miss.
(mailing address)

Red clay

5 15

WELL LOCATION:

Sand (C)

15 50

sec. 20 T-6 R-7 S-2
2 miles (distance) S. of Ocean Springs (nearest town)

Blue clay

50 88

Sand (C)

88 172

WELL PURPOSE: Home
(home, irrigation, municipal, industrial)

(C) Sand + gravel

172 200

WELL COMPLETION DATA:

Blue clay


200 323

- (1) diameter (inches) 2"
- (2) total depth (feet) 380'
- (3) static water level (feet) 65 below above top of ground.
- (4) casing PVC 370'
(material) (depth)
2" If telescope see back.
(size)
- (5) screen 10' 370'
(length) (depth to top)
2" PVC
(size) (material)
- (6) pump 1 8
(HP) (yield gpm)
elec.
(type power)
- (7) electric log NO
(yes or no)
(organization running log)
- (8) how well bottom plugged BWO

Sand (C)

323 390


DRILLERS REMARKS:

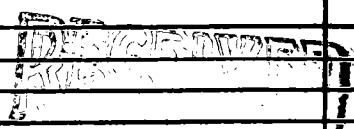

APR 8 1975

If well telescopes please sketch and show depths.

GROUND LEVEL

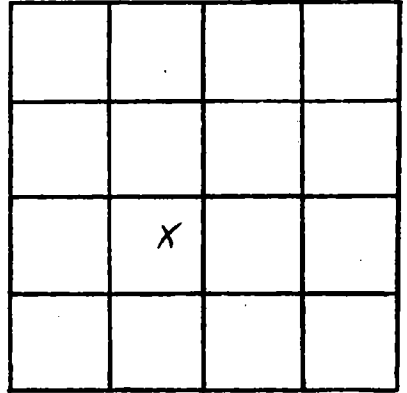

SECTION 20

Please indicate well location X.

ADDITIONAL INFORMATION

If more than one screen, show locations of each on sketch.