

JACKSON
K 2003
7-18-75

MISSISSIPPI
BOARD OF WATER COMMISSIONERS
416 North State Street
132 Jackson, Mississippi 39201
WATER WELL DRILLERS LOG

7/18 1975 ~~COAST WATER WELL SERVICE INC.~~ Jackson
date well completed firm name county well located

LANDOWNER: Leonard Howell
Rt. 4, Box 114
Ocean Springs, Miss
(mailing address)


WELL LOCATION:
sec. 9 T. 6 R. 7
in Vanhousen
(distance) miles (direction) of (nearest town)

WELL PURPOSE: Home
(home, irrigation, municipal, industrial)

- WELL COMPLETION DATA:
- (1) diameter (inches) 2"
 - (2) total depth (feet) 270'
 - (3) static water level (feet) 1' above top of ground.
 - (4) casing PVC, 260' (material) (depth)
2" (size) if telescope see back.
 - (5) screen 10' (length), 270' (depth to top)
2" (size), PVC (material)
 - (6) pump (HP) (yield gpm)
(type power)
 - (7) electric log NO (yes or no)
(organization running log)
 - (8) how well bottom plugged BWU

| description of formations encountered | from | to |
|---------------------------------------|------|-----|
| top soil | 0 | 1 |
| Red clay | 1 | 6 |
| sand (C) | 6 | 74 |
| Blue clay | 74 | 236 |
| sand (M) | 236 | 270 |

DRILLERS REMARKS:

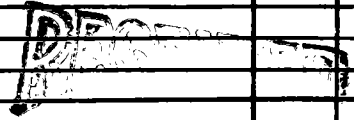

APR 2 1975

MISS. B.D.

If well telescopes please sketch and show depths.

GROUND LEVEL

| | | | |
|--|--|---|--|
| | | X | |
| | | | |
| | | | |
| | | | |

SECTION 9

Please indicate well location X.

ADDITIONAL INFORMATION

If more than one screen,
show locations of each on sketch.