

JACKSON
K 2004
6-23-75

MISSISSIPPI
BOARD OF WATER COMMISSIONERS
416 North State Street
13a Jackson, Mississippi 39201

WATER WELL DRILLERS LOG
COAST WATER WELL SERVICE INC.

6/23 1975 date well completed
Jackson firm name
Jackson county well located

LANDOWNER: Daniel Thibodeaux
Rt. 4 Box 206 C
Ocean Springs, Miss.
(mailing address)

WELL LOCATION:
sec. ~~24~~ 6 N R. ~~8~~ 7 W
3 1/2 miles SE of Vaughan
(distance) (direction) (nearest town)

WELL PURPOSE: Home
(home, irrigation, municipal, industrial)

- WELL COMPLETION DATA:
- (1) diameter (inches) 2"
 - (2) total depth (feet) 563'
 - (3) static water level (feet) 25 ^{below} above top of ground.
 - (4) casing PVC 553'
(material) (depth)
2" If telescope see back.
(size)
 - (5) screen 10' 553'
(length) (depth to top)
 - (6) pump 1 7 1/2
(HP) (yield gpm)
elec.
(type power)
 - (7) electric log NO
(yes or no)
 - (organization running log)
 - (8) how well bottom plugged BWU

description of formations encountered	from	to
<u>top soil</u>	<u>0</u>	<u>3</u>
<u>Red clay</u>	<u>3</u>	<u>18</u>
<u>sand (c)</u>	<u>18</u>	<u>79</u>
<u>Blue clay</u>	<u>79</u>	<u>241</u>
<u>sand (f)</u>	<u>241</u>	<u>261</u>
<u>Blue clay</u>	<u>261</u>	<u>432</u>
<u>sand (f)</u>	<u>432</u>	<u>439</u>
<u>(f) sand + shell</u>	<u>439</u>	<u>544</u>
<u>sand (c)</u>	<u>544</u>	<u>563</u>


DRILLERS REMARKS:

APR 3 1976

WATER COMM

If well telescopes please
sketch and show depths.

GROUND LEVEL

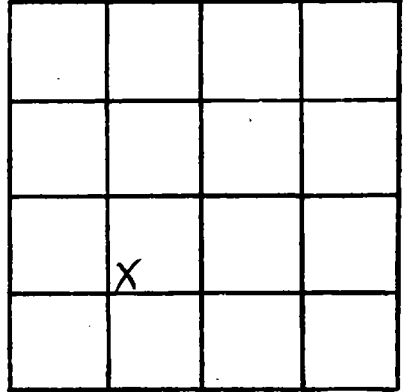

SECTION 24

Please indicate well location X.

ADDITIONAL INFORMATION

If more than one screen,
show locations of each on sketch.