

JACKSON
 K9005
 8-28-75

MISSISSIPPI
 BOARD OF WATER COMMISSIONERS
 416 North State Street
 Jackson, Mississippi 39201

WATER WELL DRILLERS LOG

AUGUST 28 1975 GARLAND WATER WELLS Jackson
 date well completed firm name county well located

LANDOWNER: SINGING RIVER
CONST. CO., 2902 BIENVILLE BLVD,
OCEAN SPRINGS, MS 39064
 (mailing address)
 WELL LOCATION:
 sec. 17 T 6 N R 7 W
3 miles SOUTH of VAN CLEVE
 (distance) (direction) (nearest town)

WELL PURPOSE: Home
 (home, irrigation, municipal, industrial)

- WELL COMPLETION DATA:
- (1) diameter (inches) 2"
 - (2) total depth (feet) 346'
 - (3) static water level (feet) 42' (below top of ground)
 - (4) casing PVC, 336'
 (material) (depth)
2" If telescope see back.
 (size)
 - (5) screen 10', 346'-336'
 (length) (depth to top)
2" PVC
 (size) (material)
 - (6) pump 1 14
 (HP) (yield gpm)
Electric
 (type power)
 - (7) electric log No
 (yes or no)
N/A
 (organization running log)
 - (8) how well bottom plugged Float Ball


description of formations encountered	from	to
TOP SOIL	0	3
RED CLAY	3	10
COURSE WHITE SAND	10	25
ORANG + WHITE CLAY	25	34
FINE WHITE SAND	34	48
MUD	48	51
COURSE WHITE SAND	51	78
MUD	78	93
COURSE YELLOW SAND	93	156
MUD	156	168
FINE GREY SAND	168	176
CLAY	176	191
MUD	191	198
CLAY	198	206
FINE SAND TO MED	206	237
MUD + CLAY STREAKS	237	260
HARD CLAY	260	294
FINE SAND	294	308
CLAY	308	317
COURSE S/P SAND	317	349
CLAY	349	

DRILLERS REMARKS:
See Reverse

WELL
 DEC 15 1975
 MISS. BD. OF WATER COMMISSIONERS

If well telescopes please sketch and show depths.

GROUND LEVEL

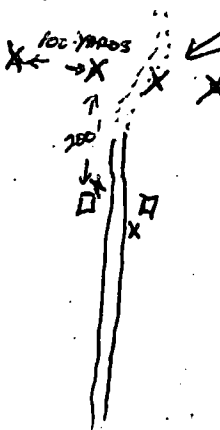

SECTION _____

Please indicate well location X.

ADDITIONAL INFORMATION

SEISMOGRAPHIC DRILLING
AND EXPLOSION APPROX
200 NORTH HAS CAUSED
DISCOLORATION AND POSSIBLE
HIGH BACTERIA

If more than one screen,
show locations of each on sketch.