

**JACKSON**  
**R 2006**  
**8-28-75**

MISSISSIPPI  
 BOARD OF WATER COMMISSIONERS  
 416 North State Street  
 Jackson, Mississippi 39201  
**WATER WELL DRILLERS LOG**

August 28 1975 Garland Water Wells JACKSON  
 date well completed firm name county well located

LANDOWNER: Stan Ramsey Realty  
Co., Hwy 90, Ocean Springs  
395604  
 (mailing address)

WELL LOCATION:  
 sec. 17 T. 6 S. R. 7 W.  
3 miles SOUTH of VAN LEAF  
 (distance) (direction) (nearest town)

WELL PURPOSE: HOME  
 (home, irrigation, municipal, industrial)

WELL COMPLETION DATA:

(1) diameter (inches) 2"

(2) total depth (feet) 346'

(3) static water level (feet) 42' below  
 top of ground.

(4) casing PVC, 336'  
 (material) (depth)

2"  
 (size) If telescope see back.

(5) screen 10', 346'-336'  
 (length) (depth to top)

2", PVC  
 (size) (material)

(6) pump 1 12  
 (HP) (yield gpm)

ELECTRIC  
 (type power)

(7) electric log No  
 (yes or no)

N/A  
 (organization running log)

(8) how well bottom plugged Flatt Ball

description of formations encountered	from	to
TOP SOIL	0	3
RED CLAY	3	10
COURSE WHITE SAND	10	25
ORANGE CLAY	25	34
FINE SAND	34	48
MUD	48	51
COURSE WHITE SAND	51	78
MUD	78	93
COURSE SAND	93	158
MUD	158	165
FINE SAND	165	180
CLAY	180	195
MUD - SOFT	195	201
CLAY	201	210
FINE SAND	210	240
MUD + CLAY STREAKS	240	263
CLAY	263	300
FINE SAND	300	310
CLAY	310	320
COURSE SIP SAND	320	350
CLAY	350	

DRILLERS REMARKS:


See Reverse

Garland Water Wells  
Aug 28 1975

MISS. BO. OF WATER COMMISSIONERS

If well telescopes please sketch and show depths.

GROUND LEVEL

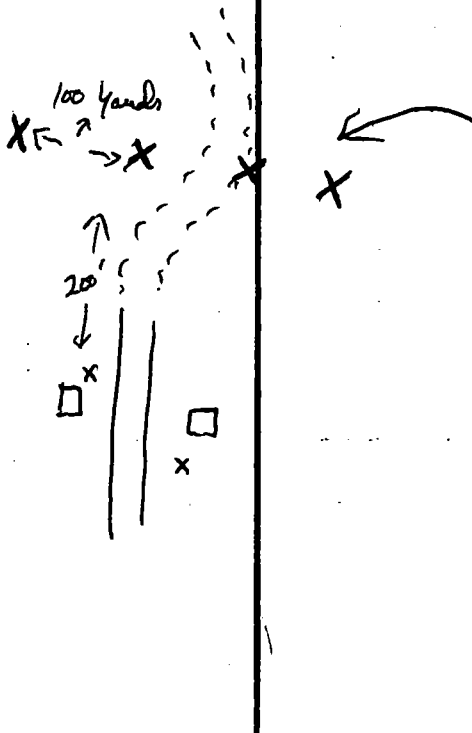


SECTION \_\_\_\_\_

Please indicate well location X.

ADDITIONAL INFORMATION

SIZEMOGRAPHIC DRILLING AND  
EXPLOSIONS APPROX 200'  
NORTH HAS CAUSED DISCOLORATION  
AND POSSIBLE HIGH BACTERIA

If more than one screen,  
show locations of each on sketch.