

JACKSON
 K 2008
 9-12-75

MISSISSIPPI
 BOARD OF WATER COMMISSIONERS
 416 North State Street
 Jackson, Mississippi 39201

WATER WELL DRILLERS LOG

SEPTEMBER 12 1975
 date well completed

13Q

GARLAND WATER WELLS
 firm name

JACKSON
 county well located


LANDOWNER: <u>H.R. KROHN</u> <u>CLEAR WATER ROAD</u>	description of formations encountered	from	to
<u>OCEAN SPRINGS, Ms 39564</u> (mailing address)	<u>TOP SOIL</u>	<u>0</u>	<u>6</u>
WELL LOCATION: sec <u>27</u> T <u>6</u> S R <u>7</u> W <u>2</u> miles <u>SOUTH</u> of <u>VAN CLEAVE</u> (distance) (direction) (nearest town)	<u>COURSE SAND</u>	<u>6</u>	<u>128</u>
WELL PURPOSE: <u>HOME</u> (home, irrigation, municipal, industrial)	<u>MUD</u>	<u>128</u>	<u>1624</u>
WELL COMPLETION DATA: (1) diameter (inches) <u>2"</u> (2) total depth (feet) <u>126'</u> (3) static water level (feet) <u>18'</u> <u>below</u> <u>above</u> top of ground. (4) casing <u>PVC</u> , <u>116'</u> (material) (depth) <u>2"</u> If telescope see back. (size) (5) screen <u>10'</u> , <u>126'-116'</u> (length) (depth to top) <u>2"</u> <u>PVC</u> (size) (material) (6) pump <u>1/2</u> <u>8-10</u> (HP) (yield gpm) <u>Electric</u> (type power) (7) electric log <u>No</u> (yes or no)			
(organization running log) (8) how well bottom plugged <u>Float Ball</u>			
DRILLERS REMARKS:			

DEC 15 1975

MISSISSIPPI WATER COMM

If well telescopes please sketch and show depths.

GROUND LEVEL

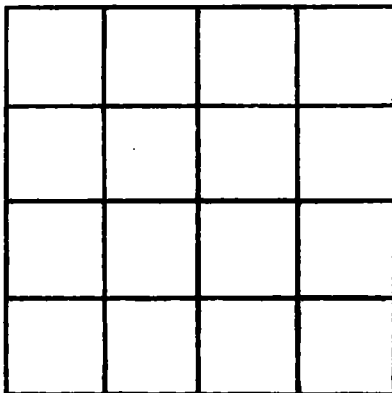

SECTION _____

Please indicate well location X.

ADDITIONAL INFORMATION

If more than one screen, show locations of each on sketch.