

**JACKSON**  
 K 2012  
 1/28/76

MISSISSIPPI  
 BOARD OF WATER COMMISSIONERS  
 416 North State Street  
 Jackson, Mississippi 39201

WATER WELL DRILLERS LOG

1/28 1976 date well completed  
 COAST WATER WELL SERVICE INC. firm name  
 Jackson county well located

LANDOWNER: Katherine Kuhn  
 Rt. 4 Box 245c  
 Ocean Springs Mo.  
 (mailing address)

WELL LOCATION:  
 sec. 14 T. 6 R. 7  
 2 miles E. of Vanhook  
 (distance) (direction) (nearest town)

WELL PURPOSE: Home  
 (home, irrigation, municipal, industrial)

WELL COMPLETION DATA:  
 (1) diameter (inches) 2"  
 (2) total depth (feet) 185'  
 (3) static water level (feet) 45 below top of ground.  
 (4) casing PVC, 175' (material) (depth)  
 2" (size) If telescope see back.  
 (5) screen 10' (length), 175' (depth to top)  
 2" (size), PVC (material)  
 (6) pump 1 (HP), 8 1/2 (yield gpm)  
 elec. (type power)  
 (7) electric log NO (yes or no)  
 (organization running log)  
 (8) how well bottom plugged B/w Value


description of formations encountered	from	to
top soil	0	3
red clay	3	11
coarse sand	11	50
red clay	50	56
sand - med.	56	138
Blue clay	138	171
sand - med.	171	185

RECEIVED  
 JUN 28 1976

DRILLERS REMARKS:

If well telescopes please sketch and show depths.

GROUND LEVEL

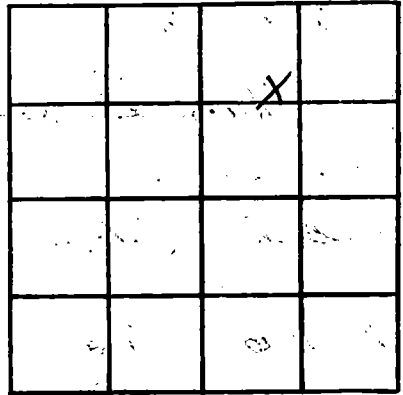

SECTION 14

Please indicate well location X.

ADDITIONAL INFORMATION

If more than one screen, show locations of each on sketch.

NO. OF SCREENS TO BE SHOWN