

JACKSON
 K 2021
 10/12/76

MISSISSIPPI
 BOARD OF WATER COMMISSIONERS
 416 North State Street
 130 Jackson, Mississippi 39201

WATER WELL DRILLERS LOG

10/12 date well completed 1976 Coast Water Well Serv. firm name Jackson county well located

LANDOWNER: <u>Cynthia Falk</u>	description of formations encountered	from	to
<u>Rt. 4 Box 278</u>			
<u>Ocean Springs, Ms.</u> (mailing address)	<u>white clay</u>	<u>3</u>	<u>33</u>
WELL LOCATION: sec. <u>9</u> T. <u>6</u> N. R. <u>7</u> W. <u>in</u> <u>Donleave</u> miles (distance) (direction) of (nearest town)	<u>hard - med to coarse</u>	<u>33</u>	<u>81</u>
	<u>blue clay</u>	<u>81</u>	<u>233</u>
	<u>hard - med to coarse</u>	<u>233</u>	<u>260</u>
WELL PURPOSE: <u>home</u> (home, irrigation, municipal, industrial)			<u>1410</u>


- WELL COMPLETION DATA:
- diameter (inches) 2"
 - total depth (feet) 268' 1/2"
 - static water level (feet) 30 below above top of ground.
 - casing PVC, 258'
(material) (depth)
2"
(size) If telescope see back.
 - screen 10', 258'
(length) (depth to top)
2", PVC
(size) (material)
 - pump 1, 7'10"
(HP) (yield gpm)
elec.
(type power)
 - electric log NO
(yes or no)
(organization running log)
 - how well bottom plugged Blue Water

RECEIVED
 MAR - 9 1977

DRILLERS REMARKS: _____
 MISS. BD. OF WATER COMMISSIONERS

If well telescopes please sketch and show depths.

GROUND LEVEL

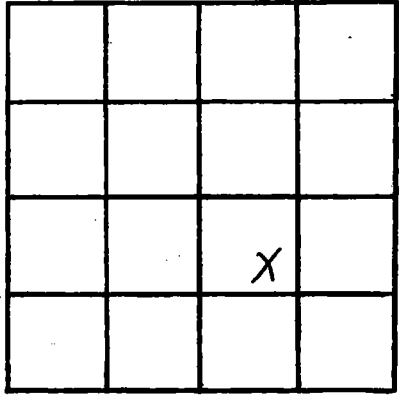

SECTION 9

Please indicate well location X.

ADDITIONAL INFORMATION

If more than one screen, show locations of each on sketch.