

JACKSON
K 2025
11-8-76

MISSISSIPPI
BOARD OF WATER COMMISSIONERS
416 North State Street
Jackson, Mississippi 39201

WATER WELL DRILLERS LOG

Nov. 8 1976 Duncan Well Drilling Jackson
date well completed firm name county well located

LANDOWNER: John C. Schaffetz
Mt. Pleasant Road
Vinclair, Miss
(mailing address)

WELL LOCATION:
sec. 1 T. 6 N. R. 7 W.
3 miles E of Vinclair
(distance) (direction) (nearest town)

WELL PURPOSE:
(home, irrigation, municipal, industrial)

WELL COMPLETION DATA:

(1) diameter (inches) 2"

(2) total depth (feet) 420'

(3) static water level (feet) 40 below above
top of ground.

(4) casing PVC, 410
(material) (depth)

 If telescope see back.
(size)

(5) screen 10", 410
(length) (depth to top)

2", stainless steel
(size) (material)

(6) pump 1/2, 5
(HP) (yield gpm)

electric
(type power)

(7) electric log
(yes or no)

(organization running log)

(8) how well bottom plugged hard
shale

description of formations encountered	from	to
mud	0	10
sand	10	25
clay	25	180
sand	180	190
Blue clay	190	295
fine sand	295	310
blue clay	310	380
fine sand	380	400
course sand	400	420


RECEIVED

JAN 8 1977

DRILLERS REMARKS:

If well telescopes please sketch and show depths.

GROUND LEVEL

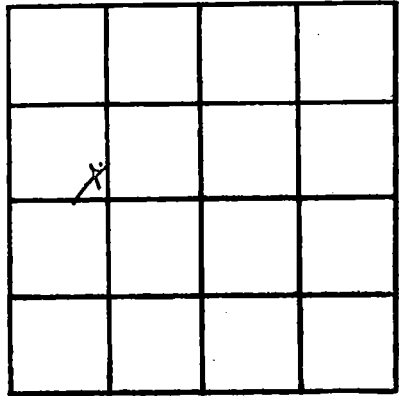

SECTION 1

Please indicate well location X.

ADDITIONAL INFORMATION

A series of 18 horizontal lines for writing additional information.

If more than one screen, show locations of each on sketch.