

JACKSON  
K 2026  
12/4/76

MISSISSIPPI  
BOARD OF WATER COMMISSIONERS  
416 North State Street  
Jackson, Mississippi 39201

WATER WELL DRILLERS LOG

12/4 1976 date well completed  
130 76 firm name  
Jackson county well located

LANDOWNER Leon Collins  
Pk 4 - Box 311 - F  
Ocean Springs, Miss. 39564  
(mailing address)

description of formations encountered	from	to
Top Soil	0	2
Red Clay	2	10
Sand (s) gravel	10	80
Blue Clay	80	116
Med. Sand	116	130
Blue Clay	130	224
Med. Sand	224	278
Blue Clay	278	322
Med. Sand	322	330

WELL LOCATION:  
sec. 9 T. 6 N. R. 7 W.  
S. W.  
in Vanclave  
(distance) miles (direction) of (nearest town)

WELL PURPOSE: None  
(home, irrigation, municipal, industrial)

WELL COMPLETION DATA:

(1) diameter (inches) 2"

(2) total depth (feet) 330'

(3) static water level (feet) 15' <sup>below</sup> <sub>above</sub> top of ground.

(4) casing P.V.C. 320'  
(material) (depth)

2 If telescope see back.  
(size)

(5) screen 10 320'  
(length) (depth to top)

2 P.V.C.  
(size) (material)

(6) pump \_\_\_\_\_  
(HP) (yield gpm)

(type power)

(7) electric log \_\_\_\_\_  
(yes or no)

(organization running log)

(8) how well bottom plugged B/w valve


DRILLERS REMARKS:

RECEIVED

MISS. BD. OF WATER

If well telescopes please sketch and show depths.

**GROUND LEVEL**

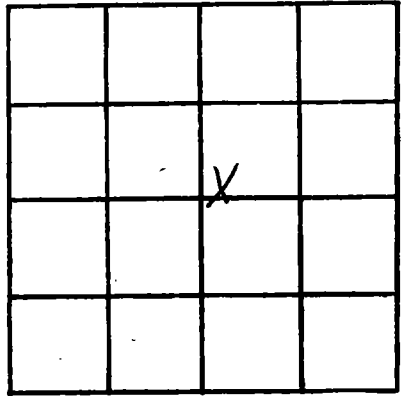

SECTION  9

Please indicate well location X.

**ADDITIONAL INFORMATION**

---



---



If more than one screen, show locations of each on sketch.