

JACKSON
 R 2028
 12/24/76

MISSISSIPPI
 BOARD OF WATER COMMISSIONERS
 416 North State Street
 Jackson, Mississippi 39201

WATER WELL DRILLERS LOG

12-24
 date well completed

1976 COAST WATER WELL SERVICE
 firm name

Jackson
 county well located

LANDOWNER: Raymond W. White
Rt 2 Box 135
Ocean Springs, Miss.
 (mailing address) 39564

description of formations encountered	depth	
	from	to
Top Soil	0	2
Red Clay	2	10
(cm) Sand	10	54
Red Clay	54	61
Sand (Course)	61	119

WELL LOCATION:
 sec. 22 T-6 S. R-2 E. W-9
2 miles S-E. of Vanclave
 (distance) (direction) (nearest town)

WELL PURPOSE: None
 (home, irrigation, municipal, industrial)

WELL COMPLETION DATA:
 (1) diameter (inches) 2
 (2) total depth (feet) 119'
 (3) static water level (feet) 30' ^{below} _{above} top of ground.
 (4) casing PVC, 109'
 (material) (depth)
2 If telescope see back.
 (size)
 (5) screen 10, 109
 (length) (depth to top)
2, P.V.C.
 (size) (material)
 (6) pump 1 hp., 8'12"
 (HP) (yield gpm)
Select.
 (type power)
 (7) electric log No.
 (yes or no)
 (organization running log)


(8) how well bottom plugged Backwash
Salut

DRILLERS REMARKS:

RECEIVED
 MAR - 9 1977
 MISS. BD. OF WATER COMM.

If well telescopes please sketch and show depths.

GROUND LEVEL

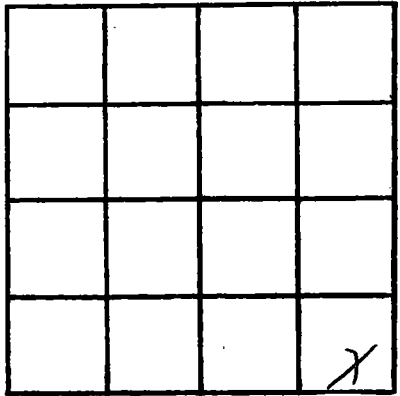

SECTION 22

Please indicate well location X.

ADDITIONAL INFORMATION

If more than one screen, show locations of each on sketch.