

JACKSON  
K 2029  
1-13-77

MISSISSIPPI  
BOARD OF WATER COMMISSIONERS  
416 North State Street  
13 & Jackson, Mississippi 39201

WATER WELL DRILLERS LOG

COAST WATER WELL SERVICE

Jackson

1-13 1977 date well completed firm name county well located

LANDOWNER:

Charles Edmiston  
Rt 2 - Box 321 B  
Ocean Springs, Miss.  
(mailing address) 39564

Description of formations encountered

from to

Top Soil	0	2
Red Clay	2	29
Sand (Med Course)	29	110
Blue Clay	110	200
Sand (fine)	200	230
Blue Clay	230	256
Sand (Med Course)	256	283
Blue Clay	283	287
Sand (Med Course)	287	325

WELL LOCATION:

sec. 8 T. 6 S. R. 7 W.  
1 1/2 miles W of Ocean Springs  
(distance) (direction) (nearest town)

WELL PURPOSE: Home  
(home, irrigation, municipal, industrial)

WELL COMPLETION DATA:

- (1) diameter (inches) 2
- (2) total depth (feet) 325
- (3) static water level (feet) 40 (below top of ground)
- (4) casing P.V.C. 315 (material) (depth)
- 2 (size) If telescope see back.
- (5) screen 10 315 (length) (depth to top)
- 2 P.V.C. (size) (material)
- (6) pump 1 hp. 8 1/2 (HP) (yield gpm)
- Select (type power)
- (7) electric log No (yes or no)
- (organization running log)

(8) how well bottom plugged Back Wash Valve


DRILLERS REMARKS:

RECEIVED  
MAR - 9 1977

MISS. BD. OF WATER COMM

If well telescopes please sketch and show depths.

GROUND LEVEL

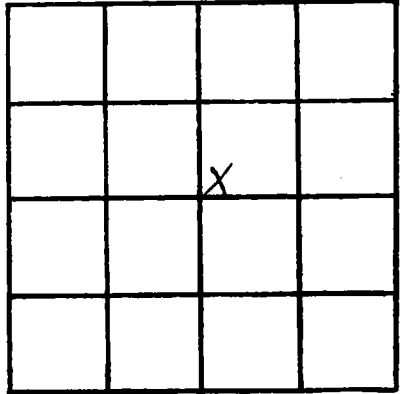

SECTION 8

Please indicate well location X.

ADDITIONAL INFORMATION

Lined area for additional information, consisting of 18 horizontal lines.

If more than one screen, show locations of each on sketch.