

JACKSON
K 2030
2/15/77

MISSISSIPPI
BOARD OF WATER COMMISSIONERS
416 North State Street
Jackson, Mississippi 39201

WATER WELL DRILLERS LOG

COAST WATER WELL SERVICE

Jackson

2-15 1977 date well completed

firm name

county well located

LANDOWNER:
Jackson County
Horticultural Div.
Pascagoula Miss.
(mailing address) 39567

description of formations encountered	from	to
Top soil	0	1
Red clay	1	8
Sand (medium)	8	16
gray clay	16	37
Sand (med.)	37	86
Blue clay	86	236
Sand medium	236	248

WELL LOCATION:

sec. 9 T. 6 S. R. 7 E.
Vanhook
(distance) miles (direction) of (nearest town)

WELL PURPOSE: Supply
(home, irrigation, municipal, industrial)

WELL COMPLETION DATA:

- (1) diameter (inches) 2"
- (2) total depth (feet) 248'
- (3) static water level (feet) 30' below top of ground
- (4) casing PVC 238' (material) (depth)
2" (size) If telescope see back.
- (5) screen 10' 238' (length) (depth to top)
2" P.V.C. (size) (material)
- (6) pump 2 HP 10 (HP) (yield gpm)
Eliot (type power)
- (7) electric log No (yes or no)

(organization running log)

(8) how well bottom plugged Backwash Value


RECEIVED
MAR - 9 1977

DRILLERS REMARKS:

MISS. BD. OF WATER COMM

If well telescopes please sketch and show depths.

GROUND LEVEL

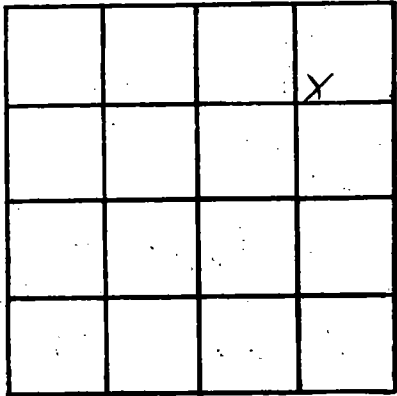

SECTION 9

Please indicate well location X.

ADDITIONAL INFORMATION

If more than one screen, show locations of each on sketch.