

JACKSON  
K 2032  
3/2/77

MISSISSIPPI  
BOARD OF WATER COMMISSIONERS  
416 North State Street  
132 Jackson, Mississippi 39201

WATER WELL DRILLERS LOG

COAST WATER WELL SERVICE

3-2-1977  
date well completed

firm name

Jackson  
county well located

LANDOWNER

*Della Mitchell*

description of formations encountered

from

to

Rt 2 - Box 253  
Ocean Springs, Miss.  
(mailing address) 39564

Top soil	0	1
red clay	1	86
Sand (Coarse)	86	102

WELL LOCATION:

sec. 4 T. 6 S. R. 7 W.  
in Vanceburg  
(distance) miles (direction) of (nearest town)

WELL PURPOSE:

Home  
(home, irrigation, municipal, industrial)

WELL COMPLETION DATA:

- (1) diameter (inches) 2
- (2) total depth (feet) 102
- (3) static water level (feet) 45 below top of ground
- (4) casing PVC (material), 92 (depth)  
2 (size) if telescope see back.
- (5) screen 10 (length), 92 (depth to top)  
2 (size), PVC (material)
- (6) pump 1/2 hp (HP), 6 (yield gpm)  
Electric (type power)
- (7) electric log No (yes or no)

(organization running log)

(8) how well bottom plugged Backwash Valve


DRILLERS REMARKS:

RECEIVED  
MAR - 9 1977

MISS. Bd. of WATER COMMISSIONERS

If well telescopes please sketch and show depths.

GROUND LEVEL

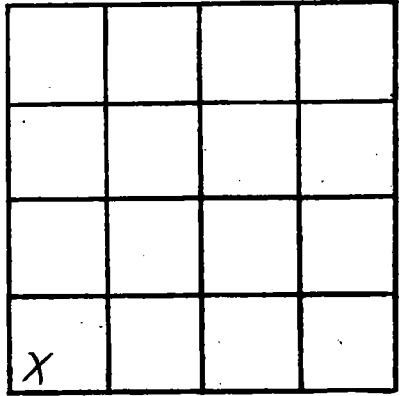

SECTION 4

Please indicate well location X.

ADDITIONAL INFORMATION

If more than one screen, show locations of each on sketch.