

JACKSON
R 0034
4-21-77

MISSISSIPPI
BOARD OF WATER COMMISSIONERS
416 North State Street
130 Jackson, Mississippi 39201

WATER WELL DRILLERS LOG

4-21-77 date well completed
Crest Water Well Serv. firm name
Jackson county well located

LANDOWNER:

Will Tanner
Rt 4 - Box 249 Ocean Springs
(mailing address) 37524

description of formations encountered

from to

description of formations encountered	from	to
Top soil	0	12
fine sand	12	25
yellow clay	25	80
fine to med. sand	80	150

WELL LOCATION:

sec. 11 T. 6 N. R. 7 E. S. 3
2 miles E. of Hancock
(distance) (direction) (nearest town)

WELL PURPOSE: Home
(home, irrigation, municipal, industrial)

WELL COMPLETION DATA:

- (1) diameter (inches) 2"
- (2) total depth (feet) 150'
- (3) static water level (feet) 45' below top of ground.
- (4) casing P.V.C. 140' (material) (depth)
2" (size) If telescope see back.
- (5) screen 10' 140' (length) (depth to top)
2" P.V.C. (size) (material)
- (6) pump 1 (HP) 6 (yield gpm)
Elec. (type power)
- (7) electric log (yes or no)
- (organization running log)

(8) how well bottom plugged
Back Wash Valve


DRILLERS REMARKS:

RECEIVED

SEP 21 1977

If well telescopes please sketch and show depths.

GROUND LEVEL

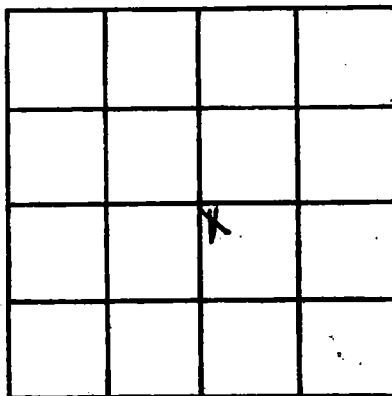

SECTION 11

Please indicate well location X.

ADDITIONAL INFORMATION

If more than one screen,
show locations of each on sketch.