

Jackson
K 2038
6-16-77

MISSISSIPPI
BOARD OF WATER COMMISSIONERS
416 North State Street
Jackson, Mississippi 39201

WATER WELL DRILLERS LOG

6-16-77 date well completed
Coast Water Well Sew. firm name
Jackson county well located

LANDOWNER: Cal Ward Tyndall
P.O. Box 269 F
Ocean Springs, Miss
(mailing address)

WELL LOCATION:
sec. 9 T. 6 S. R. 7 W.
miles of
(distance) (direction) (nearest town)

WELL PURPOSE: Home
(home, irrigation, municipal, industrial)

WELL COMPLETION DATA:
(1) diameter (inches) 2"
(2) total depth (feet) 270'
(3) static water level (feet) 25' below above
top of ground.
(4) casing PVC, 260'
(material) (depth)
2"
(size) if telescope see back.
(5) screen 10', 280'
(length) (depth to top)
2", PVC
(size) (material)
(6) pump 1 h.p., 6
(HP) (yield gpm)
Elect.
(type power)
(7) electric log No
(yes or no)

(organization running log)

(8) how well bottom plugged:
Back Wash Valve

DRILLERS REMARKS:

description of formations encountered	from	to
Top Soil	0	2
Grey clay	2	27
Sand (mc)	27	80
Blue Clay	80	235
Sand (mc)	235	270


RECEIVED

DEC 22 1977

MISS. BD. OF WATER COMMISSIONERS

If well telescopes please sketch and show depths.

GROUND LEVEL

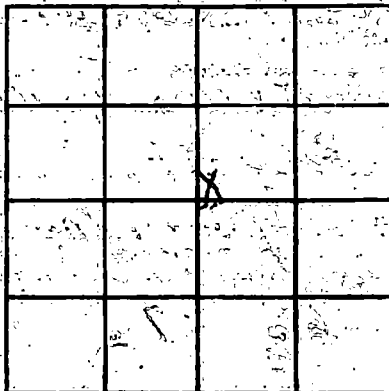

SECTION 9

Please indicate well location X.

ADDITIONAL INFORMATION

If more than one screen, show locations of each on sketch.