

Jackson
K 2042
8/30/77

MISSISSIPPI
BOARD OF WATER COMMISSIONERS
416 North State Street
130 Jackson, Mississippi 39201

WATER WELL DRILLERS LOG

Aug. 30 1977
date well completed

Griffin Well Co Jackson
firm name county well located

LANDOWNER:

Daniel McMillian
Rt 3 Ocean Springs
(mailing address)

description of formations encountered

from

to

red clay sand 0 15'
white sand 15' 26'

WELL LOCATION:

sec. 2 T. 6 N. R. 2 E. WD
2 miles North of Vidalia
(distance) (direction) (nearest town)

soft pink clay 26' 30'
yellow + white clay 30' 25'

WELL PURPOSE:

Home
(home, irrigation, municipal, industrial)

Blue clay 25' 102'

WELL COMPLETION DATA:

- (1) diameter (inches) 2"
- (2) total depth (feet) 115'
- (3) static water level (feet) 30' (below/above top of ground)
- (4) casing PVC 110' (material) (depth)

med white sand 102' 115'

if telescope see back.
(size)

- (5) screen 5' 110' (length) (depth to top)
- 2" PVC (size) (material)

- (6) pump 1 12 (HP) (yield gpm)
- ela (type power)

- (7) electric log NA (yes or no)

(organization running log)

- (8) how well bottom plugged BWV


DRILLERS REMARKS:

RECEIVED
OCT - 7 1977

MISS. BD. OF WATER COM.

If well telescopes please sketch and show depths.

GROUND LEVEL

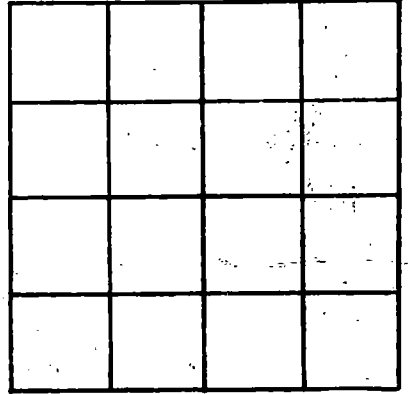

SECTION _____

Please indicate well location X.

ADDITIONAL INFORMATION

If more than one screen, show locations of each on sketch.