

Jackson
K 2043
9/26/77

MISSISSIPPI
BOARD OF WATER COMMISSIONERS
416 North State Street
Jackson, Mississippi 39201

WATER WELL DRILLERS LOG

9-26-1977 date well completed
77 Coast Water Well Serv. firm name
Jackson county well located

LANDOWNER: James Olson
Ph 6 - Box 35
Ocean Springs, Miss 39564
(mailing address)

WELL LOCATION:
sec. 15 T. 6 R. 7
1 1/2 miles E of Warrens
(distance) (direction) (nearest town)

WELL PURPOSE: Home
(home, irrigation, municipal, industrial)

WELL COMPLETION DATA:

(1) diameter (inches) 2"

(2) total depth (feet) 310'

(3) static water level (feet) 50' ^{below} _{ground}

(4) casing P.V.C. 300'
(material) (depth)
2" If telescope see back.
(size)

(5) screen 10' 300'
(length) (depth to top)

2" P.V.C.
(size) (material)

(6) pump 1 h.p. 7
(HP) (yield gpm)
Elec.
(type power)

(7) electric log No.
(yes or no)

(organization running log)

(8) How well bottom plugged?
Backwash Valve

description of formations encountered	from	to
Top soil	0	3
Red clay	3	15
Sand (mc)	15	31
Grey clay	31	61
Sand (m)	61	127
Blue clay	127	170
Sand (m)	170	187
Blue clay	187	290
Sand (m)	290	310


RECEIVED
JAN 16 1978

MISS. BD. OF WATER COMM

DRILLERS REMARKS:

If well telescopes please sketch and show depths.

GROUND LEVEL

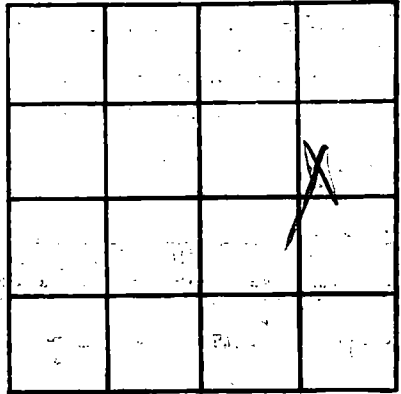

SECTION 15

Please indicate well location X.

ADDITIONAL INFORMATION

A series of horizontal lines for writing additional information, starting below the 'ADDITIONAL INFORMATION' header and extending down to the bottom of the page.

If more than one screen, show locations of each on sketch.