

Jackson
K 2044
9-27-77

MISSISSIPPI BOARD OF WATER COMMISSIONERS 416 North State Street Jackson, Mississippi 39201

WATER WELL DRILLERS LOG

9-27-77 date well completed 1977 Coastal Water Well Serv. firm name Jackson county well located

LANDOWNER: Jackson County
Developer: #2-
Vocogouly Min. (mailing address)

description of formations encountered	from	to
Top soil	0	25'
Coarse sand	25'	115'
blue clay	115'	175'
fine sand	175'	185'
blue clay	185'	285'
Med sand	285'	328'

WELL LOCATION:
sec. 16 T 6 S R 7 W
in _____ miles of _____
(distance) (direction) (nearest town)

WELL PURPOSE: domestic
(home, irrigation, municipal, industrial)

- WELL COMPLETION DATA:
- diameter (Inches) 2" x 4"
 - total depth (feet) 318'
 - static water level (feet) 45' ^(below) above top of ground
 - casing P.V.C., 300'
(material) (depth)
2" x 4" if telescope see back.
(size)
 - screen 18', 300'
(length) (depth to top)
2" PVC
(size) (material)
 - pump 1 hp, 20
(HP) (yield gpm)
Elect.
(type power)
 - electric log no-
(yes or no)
- _____
(organization running log)

(8) how well bottom plugged: Back Wash Valve

DRILLERS REMARKS: _____



RECEIVED

JAN 16 1978

MISS. BD. OF WATER COMM

If well telescopes please sketch and show depths.

GROUND LEVEL

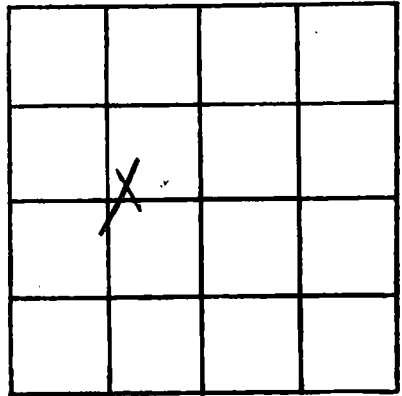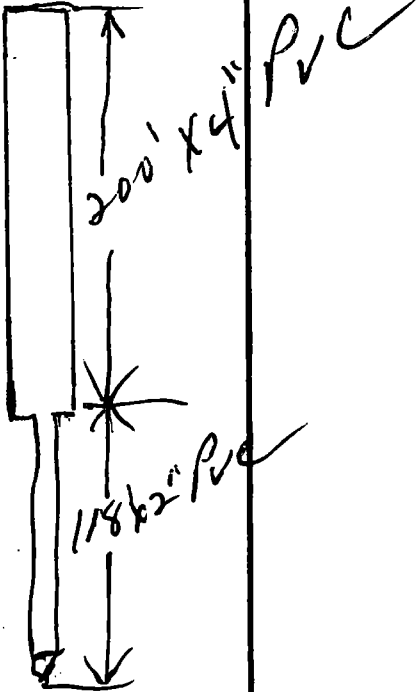

SECTION 16

Please indicate well location X.

ADDITIONAL INFORMATION

Lined area for additional information.

If more than one screen, show locations of each on sketch.