

Jackson  
K 2045  
9/28/77

MISSISSIPPI  
BOARD OF WATER COMMISSIONERS  
416 North State Street  
Jackson, Mississippi 39201

WATER WELL DRILLERS LOG

9-28-77 date well completed  
Contract Water Well Serv, Inc firm name  
Jackson county well located

LANDOWNER: Duane & Patricia  
2511 Lackwood Place  
Acaan Springs Miss 39364  
(mailing address)

WELL LOCATION:  
sec 26-T 6 S R 7 E  
3 1/2 miles East of Hanceville  
(distance) (direction) (nearest town)

WELL PURPOSE: None  
(home, irrigation, municipal, industrial)

WELL COMPLETION DATA:  
(1) diameter (inches) 2"  
(2) total depth (feet) 140  
(3) static water level (feet) 20' below top of ground.  
(4) casing P.V.C. 130' (material) (depth)  
2" (size) if telescope see back.  
(5) screen 10' 130' (length) (depth to top)  
5" P.V.C. (size) (material)  
(6) pump 1 9 (HP) (yield gpm)  
(type power)  
(7) electric log No (yes or no)  
(organization running log)  
(8) how well bottom plugged Back Wash Valve

Description of formations encountered	from	to
Top soil	0	2
Red Clay	2	10
Grey Clay	10	40
Sand Cc	40	70
White Clay	70	82
Sand (m-)	82	140

RECEIVED


JAN 16 1978

DRILLERS REMARKS:

MISS. BD. OF WATER COMMISSIONERS

If well telescopes please sketch and show depths.

GROUND LEVEL

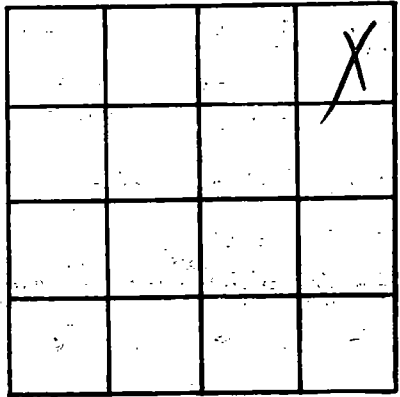

SECTION 26

Please indicate well location X.

ADDITIONAL INFORMATION

If more than one screen, show locations of each on sketch.