

Jackson  
K 2047  
11/7/77

MISSISSIPPI  
BOARD OF WATER COMMISSIONERS  
416 North State Street  
Jackson, Mississippi 39201

WATER WELL DRILLERS LOG

11-7 1977 Coast Water Well Sew. Jackson.  
date well completed firm name county well located

LANDOWNER McRay Havers  
+ Mrs. Jesse Havers.  
Rt 4 Box 299  
Ocean Springs, Miss.  
(mailing address) 39564

description of formations encountered	from	to
Top soil	0	15
Med. Sand	15	35
Blue Clay	35	55
Coarse sand	55	84
blue clay	84	236
Med. to coarse sand	236	266

WELL LOCATION: sec 9 T 6 R 7  
1/4 miles of Wendover  
(distance) (direction) (nearest town)

WELL PURPOSE: None  
(home, irrigation, municipal, industrial)

- WELL COMPLETION DATA:
- (1) diameter (inches) 2"
  - (2) total depth (feet) 266'
  - (3) static water level (feet) 15' below top of ground.
  - (4) casing PVC, 256'  
(material) (depth)  
2" If telescope see back.  
(size)
  - (5) screen 10', 256'  
(length) (depth to top)  
2", PVC  
(size) (material)
  - (6) pump 1 h.p., 10  
(HP) (yield gpm)  
Elect.  
(type power)
  - (7) electric log No.  
(yes or no)
- (organization running log)

(8) how well bottom plugged  
Back work value


DRILLERS REMARKS:

RECEIVED  
JAN 17 1978

MISS. BD. OF WATER COMM

If well telescopes please sketch and show depths.

GROUND LEVEL

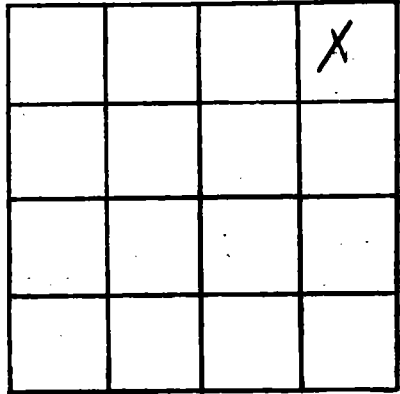

SECTION 9

Please indicate well location X.

ADDITIONAL INFORMATION

If more than one screen, show locations of each on sketch.