

Jackson
K 2048
11/8/77

MISSISSIPPI
BOARD OF WATER COMMISSIONERS
416 North State Street
Jackson, Mississippi 39201

WATER WELL DRILLERS LOG

11-8 1977 Cash water well Sew. Jackson
date well completed firm name county well located


LANDOWNER:	description of formations encountered	from	to
<u>Chuck Catton</u>	<u>Top soil</u>	<u>0</u>	<u>2</u>
<u>Rt 4 - Box 241</u>	<u>Red Clay</u>	<u>2</u>	<u>16</u>
<u>Ocean Springs, Miss.</u>	<u>Sand (mc)</u>	<u>16</u>	<u>50</u>
<u>(mailing address) 3564</u>	<u>Red Clay</u>	<u>50</u>	<u>60</u>
WELL LOCATION:	<u>Sand (mc)</u>	<u>60</u>	<u>134</u>
sec <u>12</u> T <u>6</u> R <u>7</u>	<u>Blue Clay</u>	<u>134</u>	<u>308</u>
<u>3</u> miles <u>East</u> of <u>Venice</u>	<u>Sand (mc)</u>	<u>308</u>	<u>323</u>
(distance) (direction) (nearest town)			
WELL PURPOSE: <u>Home</u>			
(home, irrigation, municipal, industrial)			
WELL COMPLETION DATA:			
(1) diameter (inches) <u>2"</u>			
(2) total depth (feet) <u>323'</u>			
(3) static water level (feet) <u>80</u> <u>below</u> <u>above</u> top of ground			
(4) casing <u>PVC</u> <u>313'</u>			
(material) (depth)			
<u>2"</u> If telescope see back.			
(size)			
(5) screen <u>10'</u> <u>313'</u>			
(length) (depth to top)			
<u>2"</u> <u>PVC</u>			
(size) (material)			
(6) pump <u>2 hp</u> <u>8</u>			
(HP) (yield gpm)			
<u>Electric</u>			
(type power)			
(7) electric log <u>No</u>			
(yes or no)			
(organization running log)			
(8) How well bottom plugged <u>backwash valve</u>			
DRILLERS REMARKS:			

RECEIVED
JAN 17 1978

MISS. Bd. OF WATER COM.

If well telescopes please
sketch and show depths.

GROUND LEVEL

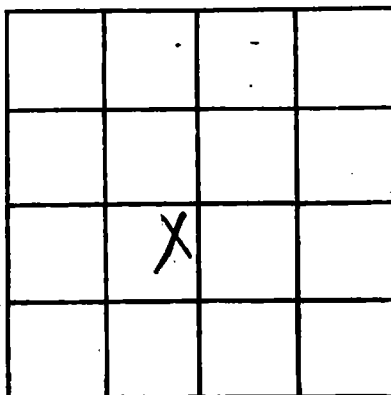

SECTION 12

Please indicate well location X.

ADDITIONAL INFORMATION

If more than one screen,
show locations of each on sketch.