

JACKSON
K2051
1-2-78

MISSISSIPPI
BOARD OF WATER COMMISSIONERS
416 North State Street
Jackson, Mississippi 39201

WATER WELL DRILLERS LOG

1-2 date well completed 78 Coast White Lake Sew. firm name Jackson county well located

LANDOWNER: Sidney Jenkins
Rt 4 Box 24 NE
Ocean Springs, Miss.
(mailing address)

description of formations encountered	from	to
Top soil	0	2
Red clay	2	12
Sand (mc)	12	60
Red clay	60	80
Sand (mc)	80	140

WELL LOCATION:
sec 14 T 6 R 7
2 miles East of Dandless
(distance) (direction) (nearest town)

WELL PURPOSE: Home
(home, irrigation, municipal, industrial)

WELL COMPLETION DATA:

(1) diameter (inches) 2"
 (2) total depth (feet) 140'
 (3) static water level (feet) 25' below above top of ground
 (4) casing PVC 130'
 (material) (depth)
 2" if telescope see back.
 (size)
 (5) screen 10' 130'
 (length) (depth to top)
 2" PVC
 (size) (material)
 (6) pump 1 hp 8
 (Hp) (yield gpm)
 Elect
 (type power)
 (7) electric log No
 (yes or no)
 (organization running log)


RECEIVED
FEB 16 1978

(8) how well bottom plugged
Air pump valve
DRILLERS REMARKS:

MISS. BD. OF WATER COMM

If well telescopes please sketch and show depths.

GROUND LEVEL

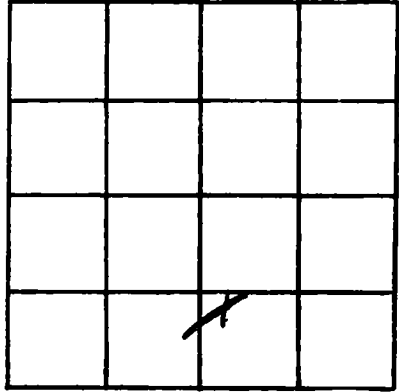

SECTION 14

Please indicate well location X.

ADDITIONAL INFORMATION

A series of horizontal lines for recording additional information.

If more than one screen, show locations of each on sketch.