

JACKSON
K 2059
1-5-78

MISSISSIPPI
BOARD OF WATER COMMISSIONERS
416 North State Street
Jackson, Mississippi 39201

WATER WELL DRILLERS LOG

1-5-78 1978 Coast Water Well Serv. Jackson
date well completed firm name county well located

LANDOWNER: Amelia Benson
Rt 4 - Box 245,
Ocean Springs, Miss.
(mailing address) 37564

WELL LOCATION:
sec. 14 T. 6 R. 7
2 miles East of Dandee
(distance) (direction) (nearest town)

WELL PURPOSE: home
(home, irrigation, municipal, industrial)

WELL COMPLETION DATA:
(1) diameter (inches) 2"
(2) total depth (feet) 423
(3) static water level (feet) 60' below
top of ground above
(4) casing P.V.C. 413.
(material) (depth)
2" If telescope see back.
(size)
(5) screen 10' 413
(length) (depth to top)
2" P.V.C.
(size) (material)
(6) pump 1-1/2 hp. 5-
(HP) (yield gpm)
Elect.
(type power)
(7) electric log No
(yes or no)
(organization running log)
(8) how well bottom plugged)
Backwash Valve

description of formations encountered	from	to
<u>Top soil</u>	<u>0</u>	<u>3</u>
<u>Red Clay</u>	<u>3</u>	<u>12</u>
<u>Red Clay + M-Sand</u>	<u>12</u>	<u>52</u>
<u>Red Clay</u>	<u>52</u>	<u>80</u>
<u>Sand (mc)</u>	<u>80</u>	<u>140</u>
<u>Blue Clay</u>	<u>140</u>	<u>170</u>
<u>Sand (m)</u>	<u>170</u>	<u>182</u>
<u>Blue Clay</u>	<u>182</u>	<u>400</u>
<u>Sand (m)</u>	<u>400</u>	<u>423</u>

RECEIVED


FEB 16 1978

MISS. BD. OF WATER COMM

DRILLERS REMARKS:

If well telescopes please sketch and show depths.

GROUND LEVEL

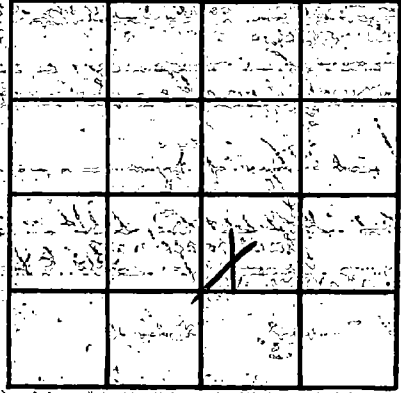

SECTION 14

Please indicate well location X.

ADDITIONAL INFORMATION

If more than one screen, show locations of each on sketch.