

JACKSON
 K 2057

MISSISSIPPI
 BOARD OF WATER COMMISSIONERS
 416 North State Street
 Jackson, Mississippi 39201

WATER WELL DRILLERS LOG

3-22 date well completed
 1978 Coast Water Well Serv. Inc. firm name
 Jackson county well located

LANDOWNER: Bill Parker
 Parks, Inc.
 P.O. Box 52302
 Lafayette, La. 70505
 (mailing address)

description of formations encountered	from	to
Top soil	0	1
Red Clay	1	15
Blue Clay	15	58
Clay sand	58	86
Sand (C)	86	130

WELL LOCATION:
 sec. 37 T. 6 S. R. 7 W.
 5 miles South E. of Dandridge
 (distance) (direction) (nearest town)

WELL PURPOSE: home
 (home, irrigation, municipal, industrial)

WELL COMPLETION DATA:

(1) diameter (inches) 2"
 (2) total depth (feet) 130'
 (3) static water level (feet) 15' (below above top of ground)
 (4) casing P.V.C. 120'
 (material) (depth)
 2" (size) if telescope see back.
 (5) screen 10' 120'
 (length) (depth to top)
 2" P.V.C.
 (size) (material)
 (6) pump 1/2 HP 8
 (HP) (yield gpm)
 Elect.
 (type power)
 (7) electric log No.
 (yes or no)
 (organization running log)


(8) how well bottom dug out
 back wash valve
 DRILLERS REMARKS:

RECEIVED
 MAY 30 1978

MISS. BD. OF WATER COMMISSIONERS

If well telescopes please sketch and show depths.

GROUND LEVEL

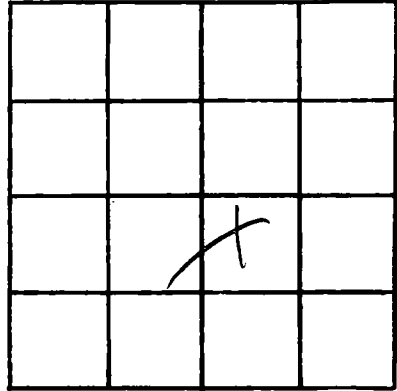

SECTION 37

Please indicate well location X.

ADDITIONAL INFORMATION

If more than one screen,
show locations of each on sketch.