

JACKSON  
K 2060

MISSISSIPPI  
BOARD OF WATER COMMISSIONERS  
416 North State Street  
Jackson, Mississippi 39201

WATER WELL DRILLERS LOG

5-31 date well completed  
98 Coast Water Well Service firm name  
Jackson county well located

LANDOWNER: Roger Rebeck  
Rt 2 - Box 242  
Ocean Springs, Miss  
(mailing address) 37564

WELL LOCATION:  
sec. 5 T. 6 S. R. 7 E.  
1 1/2 miles N. of Winleena  
(distance) (direction) (nearest town)

WELL PURPOSE: Home  
(home, irrigation, municipal, industrial)

WELL COMPLETION DATA:  
(1) diameter (inches) 2"  
(2) total depth (feet) 300'  
(3) static water level (feet) 55' <sup>below</sup> <sub>above</sub> top of ground.  
(4) casing PVC, 290'  
(material) (depth)  
2" if telescope see back.  
(size)  
(5) screen 10' 290'  
(length) (depth to top)  
2" PVC  
(size) (material)  
(6) pump 1 h.p. 6  
(HPV) (yield gpm)  
Elect.  
(type power)  
(7) electric log No.  
(yes or no)  
(organization running log)

(8) how well bottom plugged  
back wash valve

DRILLERS REMARKS:


description of formations encountered	from	to
Top soil	0	6
Red clay	6	40
Sand (mc)	40	108
Blue Clay	108	135
Sand (F)	135	145
Blue Clay	145	200
Sand (mc)	200	230
Blue Clay	230	258
Sand (mc)	258	300

RECEIVED  
AUG - 3 1978

MISS. BD. OF WATER COMM

If well telescopes please sketch and show depths.

GROUND LEVEL

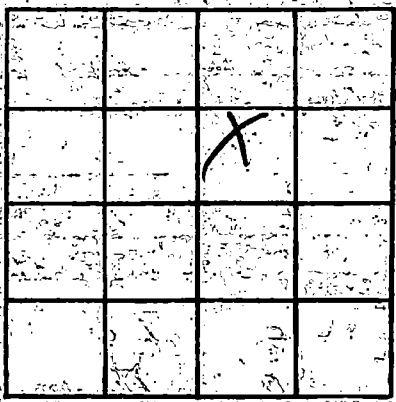

SECTION 5

Please indicate well location X:

ADDITIONAL INFORMATION

Multiple horizontal lines for additional information.

If more than one screen, show locations of each on sketch.