

JACKSON  
 K 2062

MISSISSIPPI  
 BOARD OF WATER COMMISSIONERS  
 416 North State Street  
 Jackson, Mississippi 39201

WATER WELL DRILLERS LOG

6-2-1978 date well completed  
 P.P. Coast Water Well Sew. Inc. firm name  
 Jackson county well located

LANDOWNER: Dale Shelton  
 Rt 6 - Box H 61A  
 Ocean Springs, Miss.  
 (mailing address) 37564

WELL LOCATION:  
 sec 19 T 6 R 7  
 3 miles (distance) S (direction) of Dandridge (nearest town)

WELL PURPOSE: none  
 (home, irrigation, municipal, industrial)

WELL COMPLETION DATA:

(1) diameter (inches) 2"  
 (2) total depth (feet) 370'  
 (3) static water level (feet) 60' below top of ground.  
 (4) casing PVC, 360' (material) (depth)  
 2" (size) if telescope see back.  
 (5) screen 10' (length), 360' (depth to top)  
 2" (size), P.V.C. (material)  
 (6) pump 1 h.p. (HP), 7 (yield gpm)  
 Elec. (type power)  
 (7) electric log No. (yes or no)  
 (organization running log)

description of formations encountered	from	to
Top soil	0	3-
Red clay	3	35
Sand (m)	35	60
Blue clay	60	75
Sand (mc)	75	186
Blue clay	186	215
Sand (f-m)	215	240
Blue clay	240	335
Sand (mc)	335	370

(8) how well bottom plugged  
 Back Wash Valve


DRILLERS REMARKS:

RECEIVED  
 AUG - 3 1978

MISS. BD. OF WATER COMM

If well telescopes please sketch and show depths.

GROUND LEVEL

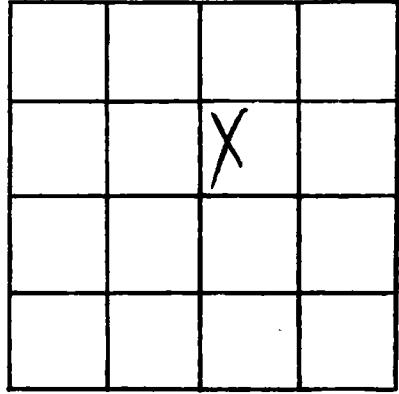

SECTION 19

Please indicate well location X.

ADDITIONAL INFORMATION

If more than one screen, show locations of each on sketch.