

JACKSON  
K 2064  
9-5-78

MISSISSIPPI  
BOARD OF WATER COMMISSIONERS  
416 North State Street  
Jackson, Mississippi 39201

WATER WELL DRILLERS LOG

9-5-78 date well completed  
Coast Water Well Service firm name  
Jackson county well located

LANDOWNER: George B. Decker  
P.O. Box 14  
Hattiesburg, Miss.  
(mailing address) 39401

description of formations encountered	from	to
Topsoil	0	2
Red Clay	2	15
Blue Clay	15	80
Red fine sand	80	123
Red coarse sand	123	133

WELL LOCATION:  
sec 24 T-6 N R-7 E  
3 1/2 miles S. East of Vicksburg  
(distance) (direction) (nearest town)

WELL PURPOSE: None  
(home, irrigation, municipal, industrial)

WELL COMPLETION DATA:

(1) diameter (inches) 2"

(2) total depth (feet) 133

(3) static water level (feet) 20' below top of ground

(4) casing PVC 123'  
(material) (depth)  
2" (size) if telescope see back.

(5) screen 10' 123'  
(length) (depth to top)  
2" (size) PVC (material)

(6) pump 1/2 h.p. 5.5  
(HP) (yield gpm)  
Elec. (type power)

(7) electric log No  
(yes or no)  
(organization running log)

(8) how well bottom plugged Backwash valve

RECEIVED


NOV - 9 1978

DRILLERS REMARKS:

MISS. BD. OF WATER COMM

If well telescopes please sketch and show depths.

GROUND LEVEL

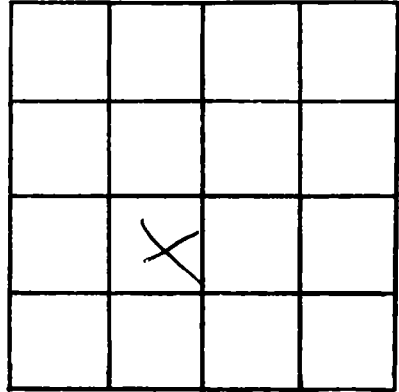

SECTION 24

Please indicate well location X.

ADDITIONAL INFORMATION

If more than one screen,  
show locations of each on sketch.