

JACKSON
 K 2069
 7-24-78

MISSISSIPPI
 BOARD OF WATER COMMISSIONERS
 416 North State Street
 Jackson, Mississippi 39201

WATER WELL DRILLERS LOG

7-24-1978 date well completed
 78 Coast Water Well Serv. Inc. firm name
 Jackson county/well located

LANDOWNER: Raymond Goff
Box 220 C,
Ocean Springs, Miss.
 (mailing address) 39564

WELL LOCATION:
 sec. 13 T. 6 N. R. 2 E.
3 miles S. East of Denochauca
 (distance) (direction) (nearest town)

WELL PURPOSE: home
 (home, irrigation, municipal, industrial)

WELL COMPLETION DATA:

(1) diameter (inches) 2"

(2) total depth (feet) 422

(3) static water level (feet) 36 ^{below} _{above} top of ground.

(4) casing PVC 412
 (material) (depth)
2" if telescope see back.
 (size)

(5) screen 10' 412
 (length) (depth to top)
2" P.V.C.
 (size) (material)

(6) pump 1 l.p. 9-
 (HP) (yield gpm)
Elect.
 (type power)

(7) electric log No
 (yes or no)

(organization running log)

description of formations encountered	from	to
Top soil	0	5
Red Clay	5	15
Red Coarse sand	15	30
Gray Clay	30	48
Gray Coarse sand	48	54
Blue Clay	54	170
Blue Fine sand	170	179
Blue Clay	179	213
Blue Fine sand	213	218
Blue Clay	218	235
Gray Fine sand	235	242
Blue Clay	242	311
Gray Med sand	311	327
Blue Clay Flom shell	322	386
Gray Coarse sand	386	422

(8) how well bottom plugged
back wash valve


DRILLERS REMARKS:

RECEIVED
 NOV 9 1978

MISS. BD. OF WATER COMM

If well telescopes please sketch and show depths.

GROUND LEVEL

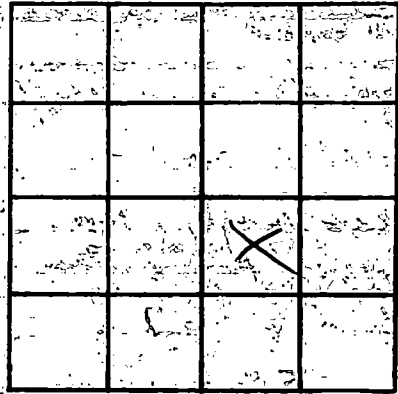

SECTION 13

Please indicate well location X.

ADDITIONAL INFORMATION

Multiple horizontal lines for additional information.

If more than one screen, show locations of each on sketch.