

JACKSON
K2073
2-26-80
2-26-

MISSISSIPPI
BOARD OF WATER COMMISSIONERS
416 North State Street
Jackson, Mississippi 39201

WATER WELL DRILLERS LOG

date well completed: 2-26-80
firm name: 80 Cas Water Well Service Jackson
county well located: Jackson

LANDOWNER: Leroy Wattman
P.O. Box 167A
Ocean Springs, Miss.
(mailing address) 37564

description of formations encountered	from to	
	ft	ft
Top soil + red clay	0	10
Red coarse sand	10	30
blue clay	30	77
gray fine sand	77	145
blue clay	145	193
gray coarse sand	193	210

WELL LOCATION:
sec. 15 T 6 N R 7 E
2 miles S.E. of Vancleave
(distance) (direction) (nearest town)

WELL PURPOSE: none
(home, irrigation, municipal, industrial)

WELL COMPLETION DATA:

(1) diameter (inches) 2"

(2) total depth (feet) 210'

(3) static water level (feet) 40' below top of ground

(4) casing PVC 200' (material) (depth)
2" (size) if telescope see back.

(5) screen 10' 200' (length) (depth to top)
2" (size) PVC (material)

(6) pump 1 H.P. 8 (HP) (yield gpm)
Elect. (type power)

(7) electric log No. (yes or no)


(organization running log)

DEPT. OF NATURAL RESOURCES
BUREAU OF LAND & WATER RESOURCES
JUL - 2 1980
RECEIVED

(8) how well bottom plugged: back wash valve
DRILLERS REMARKS:

If well telescopes please sketch and show depths.

GROUND LEVEL

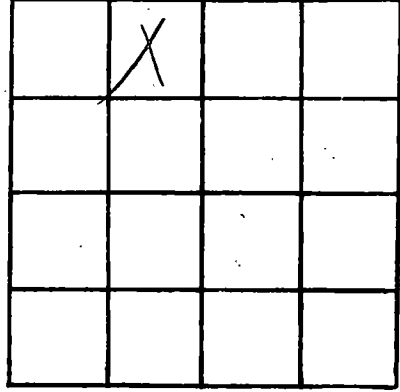

SECTION 15

Please indicate well location X.

ADDITIONAL INFORMATION

If more than one screen, show locations of each on sketch.