

JACKSON  
K 2082  
8-15-79

MISSISSIPPI  
BOARD OF WATER COMMISSIONERS  
416 North State Street  
Jackson, Mississippi 39201

WATER WELL DRILLERS LOG

8-15-79 date well completed  
Crest Water Well Serv. Inc. firm name  
Jackson county well located

LANDOWNER: Weldon "Pop" Neal  
3708 Highway 90 W.  
Gautier, Miss 39533  
(mailing address)

WELL LOCATION:  
sec. 34 T 6 R 7  
4 1/4 miles South of Pardue  
(distance) (direction) (nearest town)

WELL PURPOSE: home  
(home, irrigation, municipal, industrial)

WELL COMPLETION DATA:  
(1) diameter (inches) 3"  
(2) total depth (feet) 300'  
(3) static water level (feet) 15' below top of ground.  
(4) casing PVC, 290'  
(material) (depth)  
2" If telescope see back.  
(size)  
(5) screen 10', 290'  
(length) (depth to top)  
2", PVC  
(size) (material)  
(6) pump 1 h.p., 9  
(HP) (yield gpm)  
Elect.  
(type power)  
(7) electric log No  
(yes or no)  
(organization running log)


(8) how well bottom plugged  
Back Wash Valve  
DRILLERS REMARKS:

description of formations encountered	from	to
Top soil	0	3
Red Clay	3	10
Blue Clay	10	40
Red Coarse sand	40	54
Red Clay & Shale zone	54	90
Red Coarse sand	90	151
Blue Clay	151	264
Dark Coarse sand	264	300

DEPT. OF NATURAL RESOURCES  
BUREAU OF LAND & WATER RESOURCES  
FEB 26 1980  
RECEIVED

If well telescopes please sketch and show depths.

GROUND LEVEL

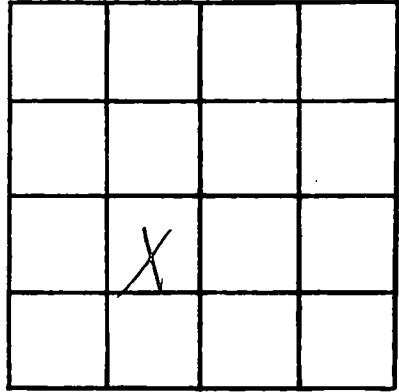

SECTION 34

Please indicate well location X.

ADDITIONAL INFORMATION

Lined area for providing additional information.

If more than one screen, show locations of each on sketch.