

Jackson
K 2088
7-5-79

MISSISSIPPI
BOARD OF WATER COMMISSIONERS
416 North State Street
Jackson, Mississippi 39201

42

WATER WELL DRILLERS LOG

7-5-1979 date well completed
Coastal Water Well Serv. Inc. firm name
Jackson county well located

LANDOWNER: Defflon Davis
Rt 4 - Box 84
Ocean Springs Miss.
(mailing address) 39564

WELL LOCATION:
sec 29 T 6 R 7 E
3 miles South of Wandeeva
(distance) (direction) (nearest town)

WELL PURPOSE: Home
(home, irrigation, municipal, industrial)

WELL COMPLETION DATA:

(1) diameter (inches) 2"

(2) total depth (feet) 382'

(3) static water level (feet) 65 ^{below} above top of ground.

(4) casing PVC 372'
(material) (depth)

2"
(size) If telescope see back.

(5) screen 10' 372'
(length) (depth to top)

2" PVC
(size) (material)

(6) pump 1 hp. 7 1/2
(HP) (yield gpm)

Electric
(type power)

(7) electric log No
(yes or no)

(organization running log)

(8) how well bottom plugged
Back wash valve

DRILLERS REMARKS:

description of formations encountered	from	to
Top soil	0	4
Red Clay	4	21
Red Clay - m-sand	21	40
Blue Clay	40	54
Sand (m)	54	70
Blue Clay	70	90
Sand (m)	90	183
Blue Clay	183	328
Sand (mc)	328	382


DEPT. OF NATURAL RESOURCES
BUREAU OF LAND & WATER RESOURCES

FEB 26 1980

RECEIVED

If well telescopes please sketch and show depths.

GROUND LEVEL

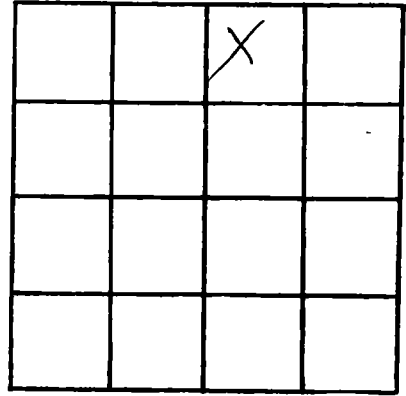

SECTION 29

Please indicate well location X.

ADDITIONAL INFORMATION

If more than one screen,
show locations of each on sketch.