

Jackson  
 K 2089  
 6-13-79

MISSISSIPPI  
 BOARD OF WATER COMMISSIONERS  
 416 North State Street  
 Jackson, Mississippi 39201

WATER WELL DRILLERS LOG

6-13-79 date well completed  
 Coast Water Well Serv. Inc. firm name  
 Jackson county well located

LANDOWNER	description of formations encountered	from	to
Martin Collier 5903 South Gulf Manor Dr. Pensacola, Fla. (mailing address)	Top soil	0	2
	Red Clay	2	20
	Sand (C)	20	65
	Gray Clay	65	74
	Sand (C)	74	128

LANDOWNER: Martin Collier  
 5903 South Gulf Manor Dr.  
 Pensacola, Fla.  
 (mailing address)

WELL LOCATION:  
 sec 25 T 6 R 7  
 3 1/2 miles S.E. of Vandewater  
 (distance) (direction) (nearest town)

WELL PURPOSE: Home  
 (home, irrigation, municipal, industrial)

- WELL COMPLETION DATA:
- (1) diameter (inches) 2"
  - (2) total depth (feet) 128'
  - (3) static water level (feet) 20 below top of ground
  - (4) casing PVC 118' (material) (depth)  
2" (size) if telescope see back.
  - (5) screen 10' 118' (length) (depth to top)  
2" (size) PVC (material)
  - (6) pump 1/2 hp. 7 (HP) (yield gpm)  
Elec (type power)
  - (7) electric log No (yes or no)
- (organization running log)

(8) How well bottom plugged  
 Back wash Valve

DEPT. OF NATURAL RESOURCES  
 BUREAU OF LAND & WATER RESOURCES


JAN 25 1980

DRILLERS REMARKS:

RECEIVED

If well telescopes please sketch and show depths.

GROUND LEVEL

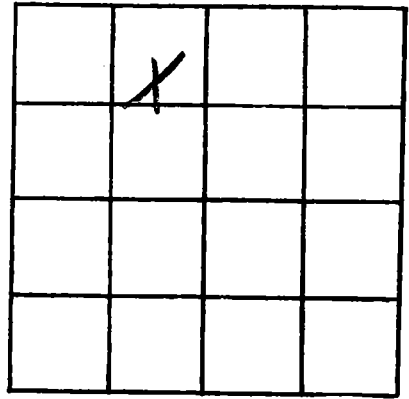

SECTION 25

Please indicate well location X.

ADDITIONAL INFORMATION

If more than one screen, show locations of each on sketch.