

JACKSON  
K 2094

MISSISSIPPI  
BOARD OF WATER COMMISSIONERS  
416 North State Street  
Jackson, Mississippi 39201

WATER WELL DRILLERS LOG

1-8-81

1 8 1981  
date well completed

Engel well Sinc  
firm name

Jackson  
county well located

LANDOWNER: JAMES Freeman  
Rt. 4, Box 225 A  
Ocean Springs, MS 39564  
(mailing address)

description of formations encountered	from	to
Top Soil	0	2
Sand	2	12
Clay	12	40
Blue Clay	40	150
fine sand	150	155
Clay	155	250
red sand	250	270
Blue Clay	270	340
Sand	340	360
Blue Clay	360	415
Sand	415	436

WELL LOCATION:  
sec. 5 T. 6 N. R. 7 E  
6 miles W of VANDEAUVE  
(distance) (direction) (nearest town)

WELL PURPOSE:  
Home, Irrigation, municipal, Industrial

WELL COMPLETION DATA:

- (1) diameter (Inches) 4x2
- (2) total depth (feet) 436'
- (3) static water level (feet) 21' <sup>below</sup> <sub>above</sub> top of ground.
- (4) casing PVC, 416'  
(material) (depth)  
4x2 if telescope see back.  
(size)
- (5) screen 20', 416'  
(length) (depth to top)  
2", PVC  
(size) (material)
- (6) pump 1/3 10  
(HP) (yield gpm)  
E/E  
(type power)
- (7) electric log (yes or no)

(organization running log)

(8) how well bottom plugged 2" pvc  
Backwash

DRILLERS REMARKS:


DEPT. OF NATURAL RESOURCES  
BUREAU OF LAND & WATER RESOURCES

JAN 15 1981

RECEIVED

If well telescopes please sketch and show depths.

GROUND LEVEL

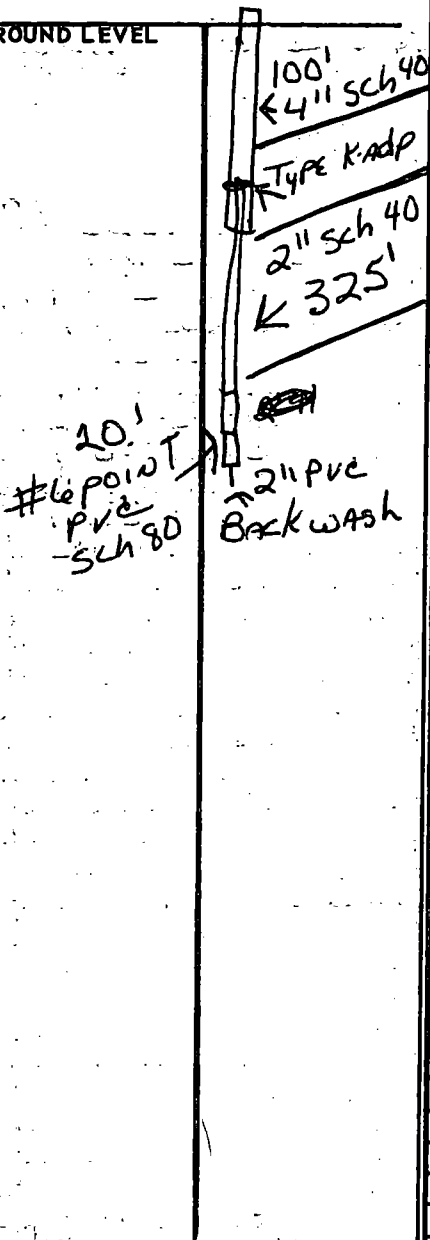

	X		

SECTION L3

Please indicate well location X.

ADDITIONAL INFORMATION

If more than one screen, show locations of each on sketch.