

JACKSON
K 2100
9/30/80
H-30-

MISSISSIPPI
BOARD OF WATER COMMISSIONERS
416 North State Street
Jackson, Mississippi 39201

WATER WELL DRILLERS LOG

date well completed

firm name

county well located

50 Coast Water Well Service, Inc. Jackson

LANDOWNER:

Robert Ross

description of formations encountered

from

to

Rt 4, Box 210

Top soil

0

3

Ocean Springs, Miss.
(mailing address) 39564

Red Clay

3

10

WELL LOCATION:

sec. 24 T 6 S R 7 E
3 miles SE of VANCELAKE
(distance) (direction) (nearest town)

Med. Sand

10

50

WELL PURPOSE:

(home, irrigation, municipal, industrial)

Home

WELL COMPLETION DATA:

(1) diameter (inches) 2"

(2) total depth (feet) 50'

(3) static water level (feet) 18' below top of ground

(4) casing PVC 40'
(material) (depth)

2" If telescope see back.
(size)

(5) screen 10' 40'
(length) (depth to top)

2" PVC
(size) (material)

(6) pump (HP) (yield gpm)

(type power)

(7) electric log No
(yes or no)

(organization running log)

(8) How well bottom plugged
Back Wash Valve

DEPT. OF NATURAL RESOURCES
BUREAU OF LAND & WATER RESOURCES


APR - 6 1981

RECEIVED

DRILLERS REMARKS:

If well telescopes please sketch and show depths.

GROUND LEVEL

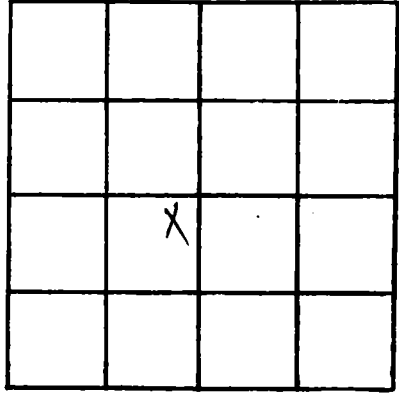

SECTION 24

Please indicate well location X.

ADDITIONAL INFORMATION

If more than one screen, show locations of each on sketch.