

**MISSISSIPPI
BOARD OF WATER COMMISSIONERS
416 North State Street
Jackson, Mississippi 39201**

WATER WELL DRILLERS LOG

JACKSON
K 2101

11-12-80

11-12-80
date well completed

80 Coastal Water Well Service Jackson
firm name county well located

LANDOWNER:

A. O. Walker

description of formations encountered

from to

Box 4 - Box 173 - P

Top soil

0 1'

O. Springs Miss
(mailing address) 37564

Red Clay

1' 30'

WELL LOCATION:

C. Sand

30' 55'

37 sec T 6 R 7
4 miles SE of WANCELAWS
(distance) (direction) (nearest town)

B. Clay

55' 68'

WELL PURPOSE:

Home
(home, irrigation, municipal, industrial)

M. Sand

68' 130'

WELL COMPLETION DATA:

- (1) diameter (inches) 2"
- (2) total depth (feet) 130'
- (3) static water level (feet) 15' ^{below} above top of ground.
- (4) casing PVC, 120'
(material) (depth)
2"
(size) if telescope see back.
- (5) screen 10', 120'
(length) (depth to top)
- (6) pump 1/2 h.p., 8
(HP) (yield gpm)
Electric
(type power)
- (7) electric log No
(yes or no)
N/A
(organization running log)
- (8) how well bottom plugged
back wash valve

DRILLERS REMARKS:


DEPT. OF NATURAL RESOURCES
BUREAU OF LAND & WATER RESOURCES

APR - 6 1981

RECEIVED

If well telescopes please sketch and show depths.

GROUND LEVEL

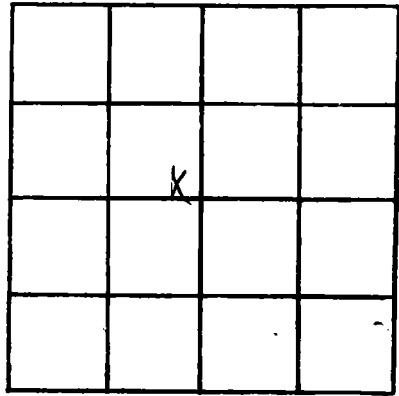

SECTION ~~37~~ 37

Please indicate well location X.

ADDITIONAL INFORMATION

If more than one screen, show locations of each on sketch.