

JACKSON
K 2102
11-13-80
11-13-

MISSISSIPPI
BOARD OF WATER COMMISSIONERS
416 North State Street
Jackson, Mississippi 39201

WATER WELL DRILLERS LOG

80 Coash Water Well Inc. Jackson
date well completed firm name county well located

LANDOWNER: Charles C. Walker
Rt 2 - Box 80
Wiggins, Miss.
(mailing address)

description of formations encountered	from	to
	Top soil	0
Red Clay	3	43'
M. sand	43'	130

WELL LOCATION:
sec 37 T 6 N R 7 E
4 miles SE of VANLEONE
(distance) (direction) (nearest town)

WELL PURPOSE: Home
(home, irrigation, municipal, Industrial)

WELL COMPLETION DATA:

(1) diameter (inches) 2"

(2) total depth (feet) 130'

(3) static water level (feet) 18' ^{below} top of ground

(4) casing PVC 120'
(material) (depth)
2" if telescope see back.
(size)

(5) screen 10' 120'
(length) (depth to top)
2" PVC
(size) (material)

(6) pump (HP) (yield gpm)
Elect. (type power)

(7) electric log No.
(yes or no)
N/A.
(organization running log)

(8) (has well bottom plugged) back wash valve

DRILLERS REMARKS:


DEPT. OF NATURAL RESOURCES
BUREAU OF LAND & WATER RESOURCES

APR - 6 1981

RECEIVED

If well telescopes please sketch and show depths.

GROUND LEVEL

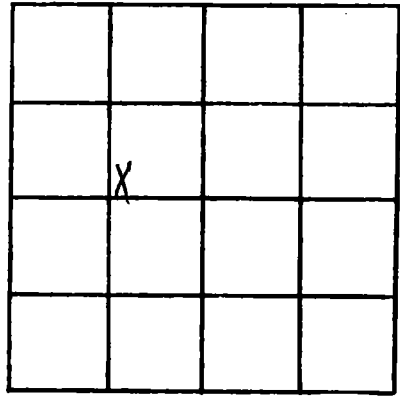

SECTION 37

Please indicate well location X.

ADDITIONAL INFORMATION

If more than one screen, show locations of each on sketch.