

MISSISSIPPI DEPARTMENT OF NATURAL RESOURCES

Bureau of Land and Water Resources

Southport Mall

P.O. Box 10631

Jackson, Mississippi 39209

WATER WELL DRILLERS LOG

JACKSON
K 2103
1-7-81
1-7-81

date well completed

firm name

county well located

Coast Water Well Serv. Jackson

LANDOWNER

Robert R. Kuntz

description of formations encountered

from

to

Rt. 4 Box 208A -
Ocean Springs, Miss.
(mailing address) 39564

Top soil	0	2'
Red Clay	2'	12'
Red Coarse sand	12'	45'
Blue Clay	45'	240'
gray Coarse sand	240'	260'

WELL LOCATION:

sec. 13 T. 6 S. R. 7 W. of VANCELAKE
3 1/2 miles (distance) E (direction) (nearest town)

WELL PURPOSE:

(home, irrigation, municipal, industrial)

Home

WELL COMPLETION DATA:

- (1) diameter (inches) 2"
- (2) total depth (feet) 260'
- (3) static water level (feet) 74 below top of ground.
- (4) casing PVC (material), 250' (depth)
- (size) 2" if telescope see back.
- (5) screen 10' (length), 250' (depth to top)
- (size) 2" (material) PVC
- (6) pump 2 HP (HP), 10 (yield gpm)
- (type power) Elec.
- (7) electric log No. (yes or no)
- (organization running log)

(8) Is well bottom plugged? Back Wash Valve

DRILLERS REMARKS:


DEPT. OF NATURAL RESOURCES
BUREAU OF LAND & WATER RESOURCES

APR - 6 1981

RECEIVED

If well telescopes please sketch and show depths.

GROUND LEVEL

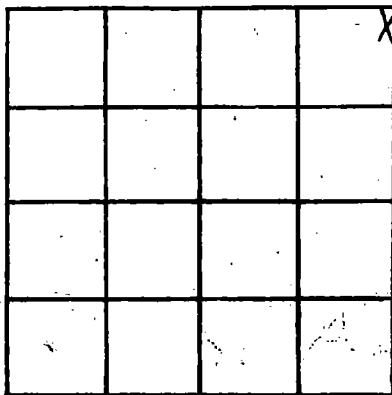

SECTION 13

Please indicate well location X.

ADDITIONAL INFORMATION

If more than one screen,
show locations of each on sketch.