

MISSISSIPPI DEPARTMENT OF NATURAL RESOURCES

Bureau of Land and Water Resources

Southport Mall

P.O. Box 10631

Jackson, Mississippi 39209

WATER WELL DRILLERS LOG

JACKSON  
K 9105  
1-26-81  
1-26-81

date well completed

firm name

county well located

19 Coast Water Well Dr. Inc. Jackson

LANDOWNER:

R. E. Cox

description of formations encountered

from

to

Rt 4 - Box 252c

Top soil

0 2'

Ocean Springs Miss.  
(mailing address) 39564

Red. Clay

2 14'

WELL LOCATION:

sec. 11 T. 6 S. R. 7 E.  
2 miles E of Terrebonne  
(distance) (direction) (nearest town)

M - Sand

14 43'

R - Clay

43' 80'

M - Sand

80' 120'

WELL PURPOSE:

(home, irrigation, municipal, industrial)

None

WELL COMPLETION DATA:

- (1) diameter (inches) 2"
- (2) total depth (feet) 120'
- (3) static water level (feet) 40' below top of ground.
- (4) casing PVC (material), 110' (depth)  
2" (size) if telescope see back.
- (5) screen 10' (length), 110' (depth to top)  
2" (size), PVC (material)
- (6) pump 1/2 H.P. (HP), 7 1/2 (yield gpm)  
Elect. (type power)
- (7) electric log No (yes or no)  
(organization running log)

(8) how well bottom plugged Backwash Valve

DRILLERS REMARKS:


DEPT. OF NATURAL RESOURCES  
BUREAU OF LAND & WATER RESOURCES

APR - 6 1981

RECEIVED

If well telescopes please sketch and show depths.

GROUND LEVEL

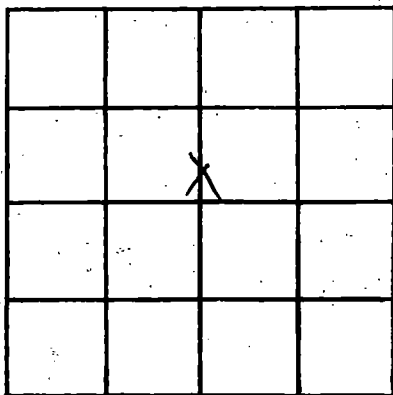

SECTION 12

Please indicate well location X.

ADDITIONAL INFORMATION

If more than one screen, show locations of each on sketch.